


# 110 WALL STREET

RUDIN

**Floor 2**  
**17,000 Sq. Ft.**  
**Entire Floor Available**

**As-Built Plan**  
**Price Available Upon Request**

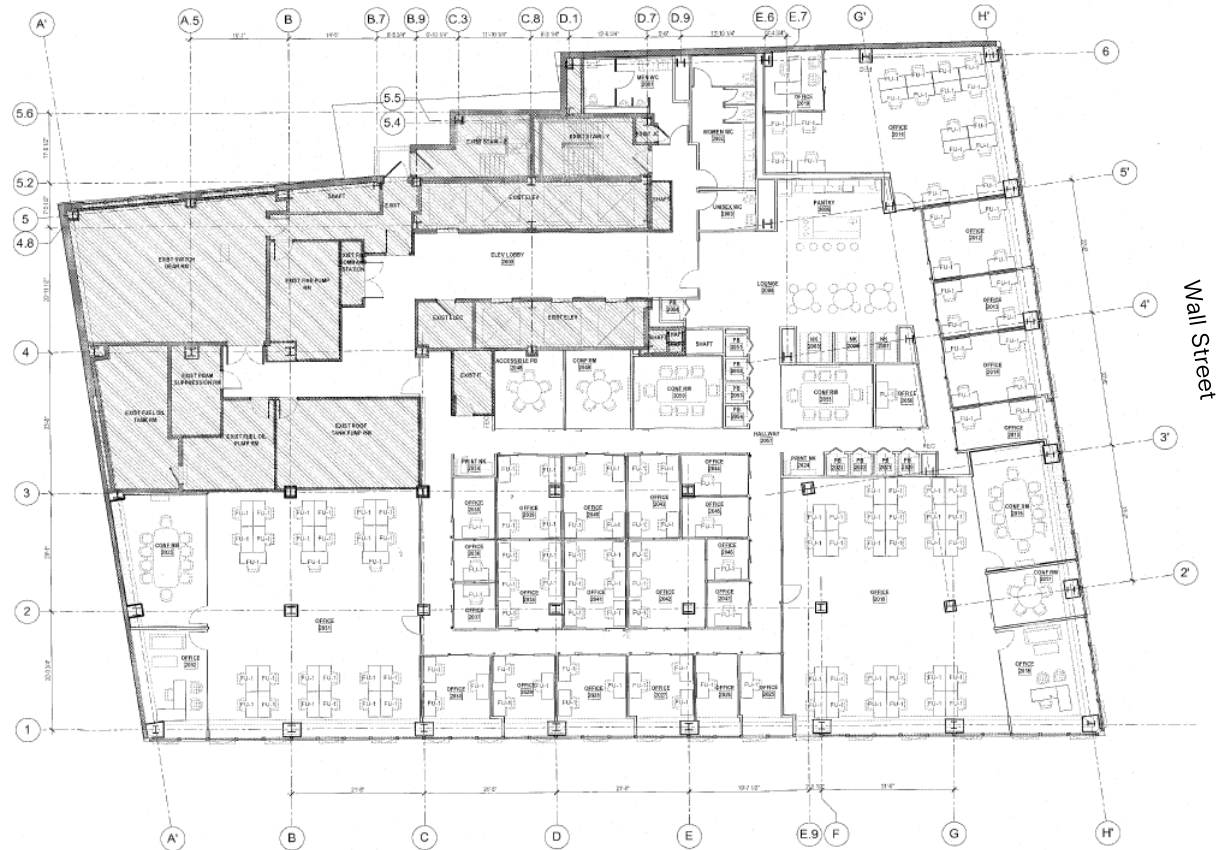

**Kevin Daly**

212.407.2437  
kdaly@rudin.com

[rudin.com](http://rudin.com)

Front Street

Wall Street



REBNY