


110 WALL STREET

RUDIN

Floor 3
19,233 Sq. Ft.
Entire Floor Available

As-Built Plan
Price Available Upon Request

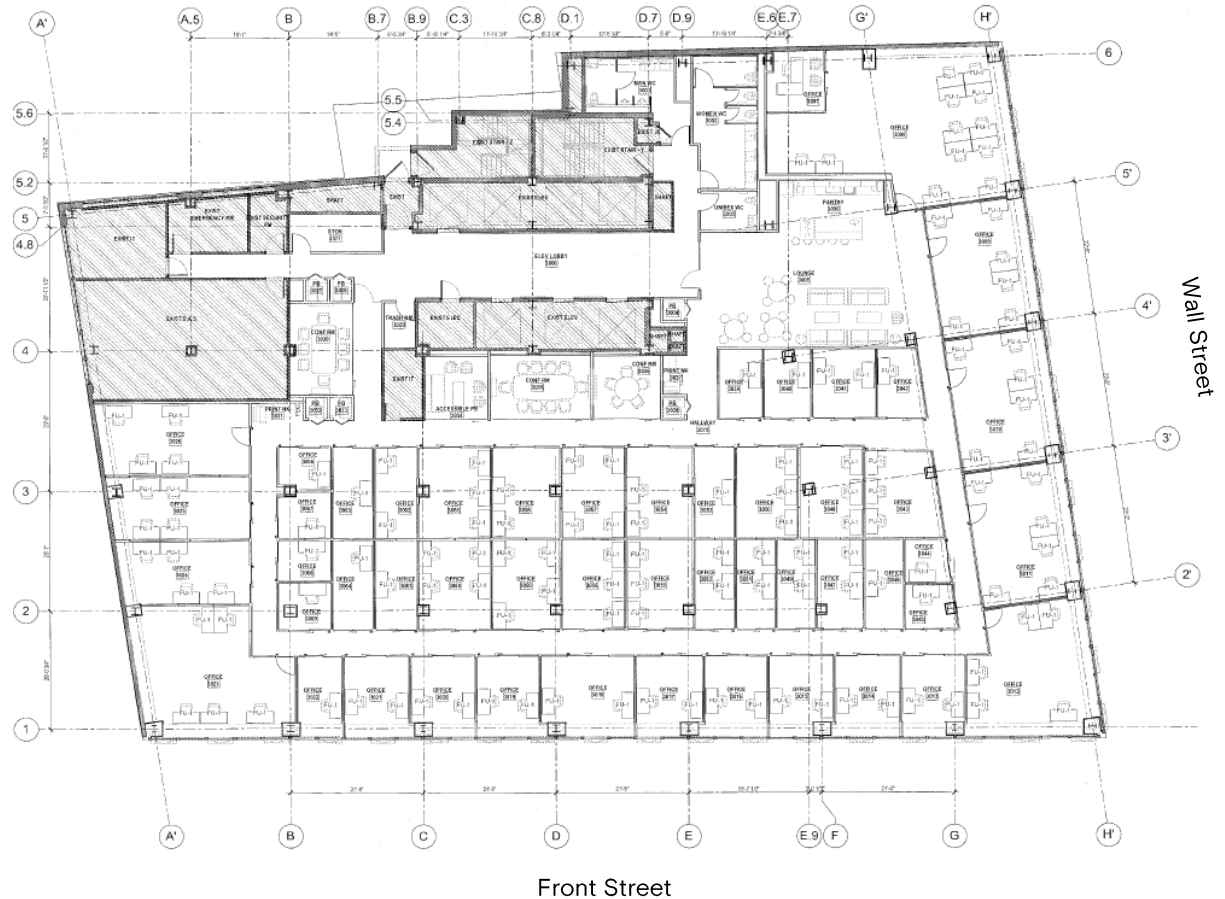

Kevin Daly

212.407.2437
kdaly@rudin.com

rudin.com



REBNY