


110 WALL STREET

Floor 4
19,358 Sq. Ft.
Entire Floor Available

As-Built Plan
Price Available Upon Request

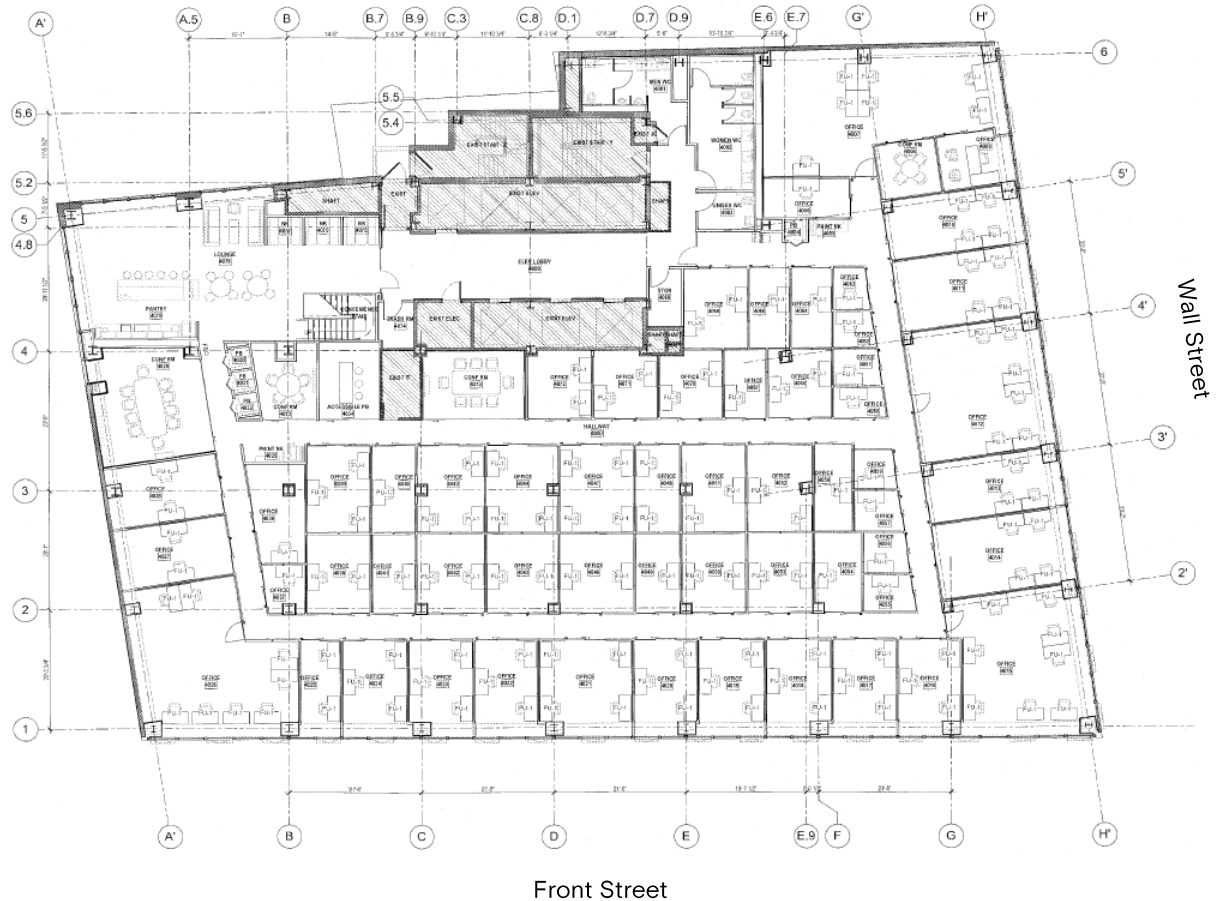

Kevin Daly

212.407.2437
kdaly@rudin.com

rudin.com

RUDIN



REBNY