


# 1675 BROADWAY

RUDIN

**Partial 21<sup>st</sup> Floor  
10,793 Sq. Ft.  
As Built Plan**

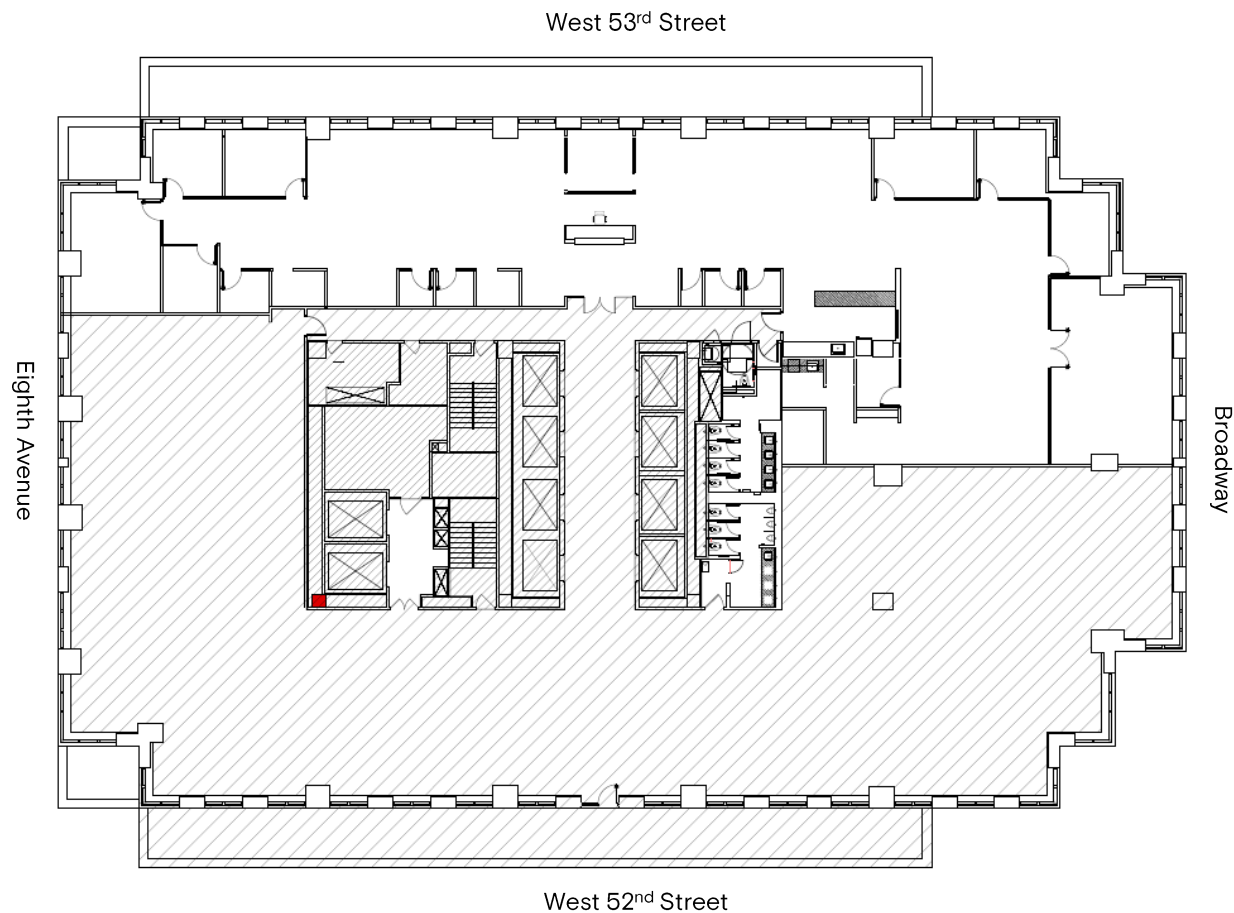

**Robert Steinman**

212.407.2490  
rsteinman@rudin.com

[rudin.com](http://rudin.com)



REBNY