



# One Battery Park Plaza

Rudin

Floor 25  
Core and Shell Plan

15,623 Sq. Ft.  
Partial Floor Available  
July 2020

---

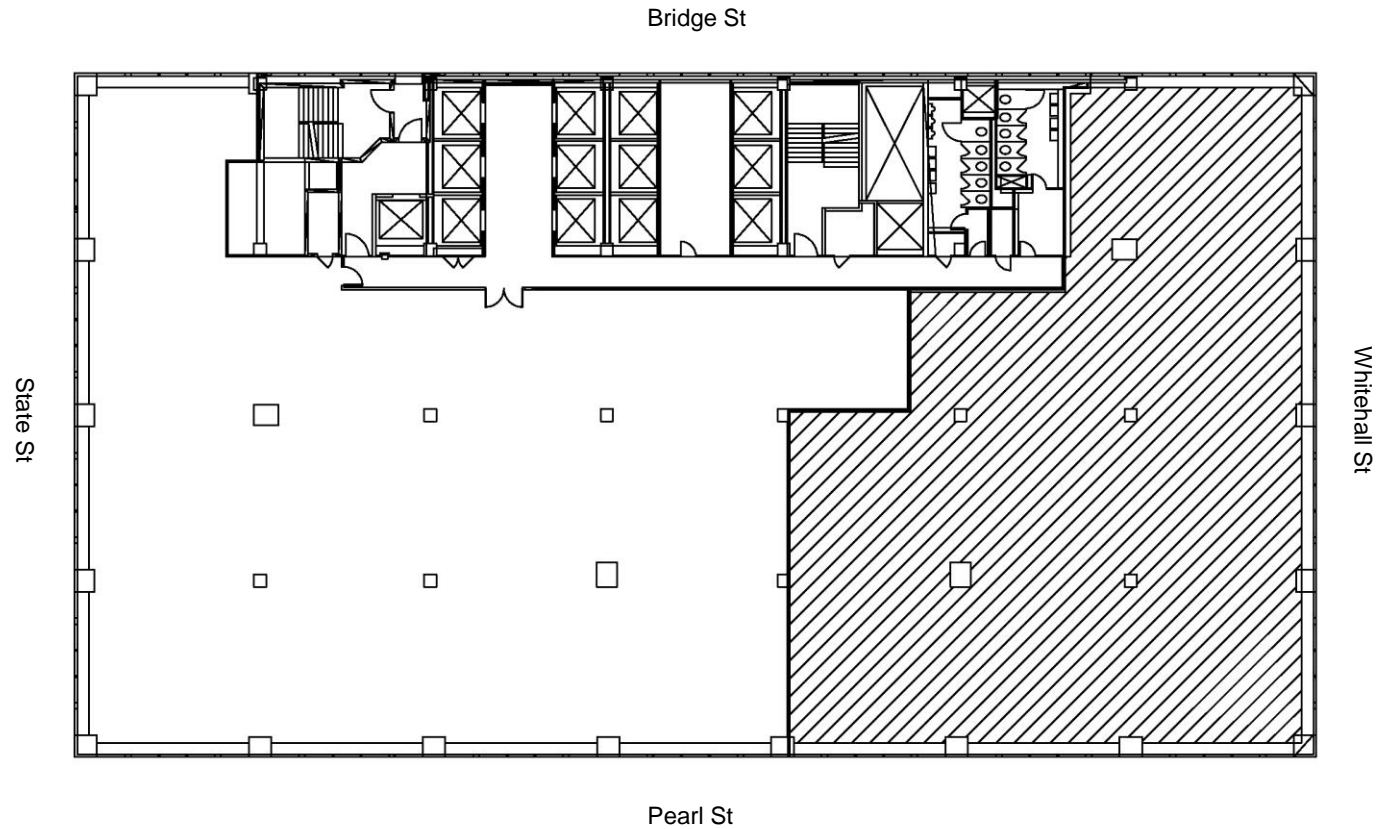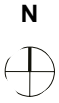

Kevin Daly

Thomas M. Keating

212.407.2437  
kdaly@rudin.com

212.407.2481  
tkeating@rudin.com

[rudin.com](http://rudin.com)



REBNY


# One Battery Park Plaza

Rudin

Floor 25  
As Built Plan

15,623 Sq. Ft.  
Partial Floor Available  
July 2020

---

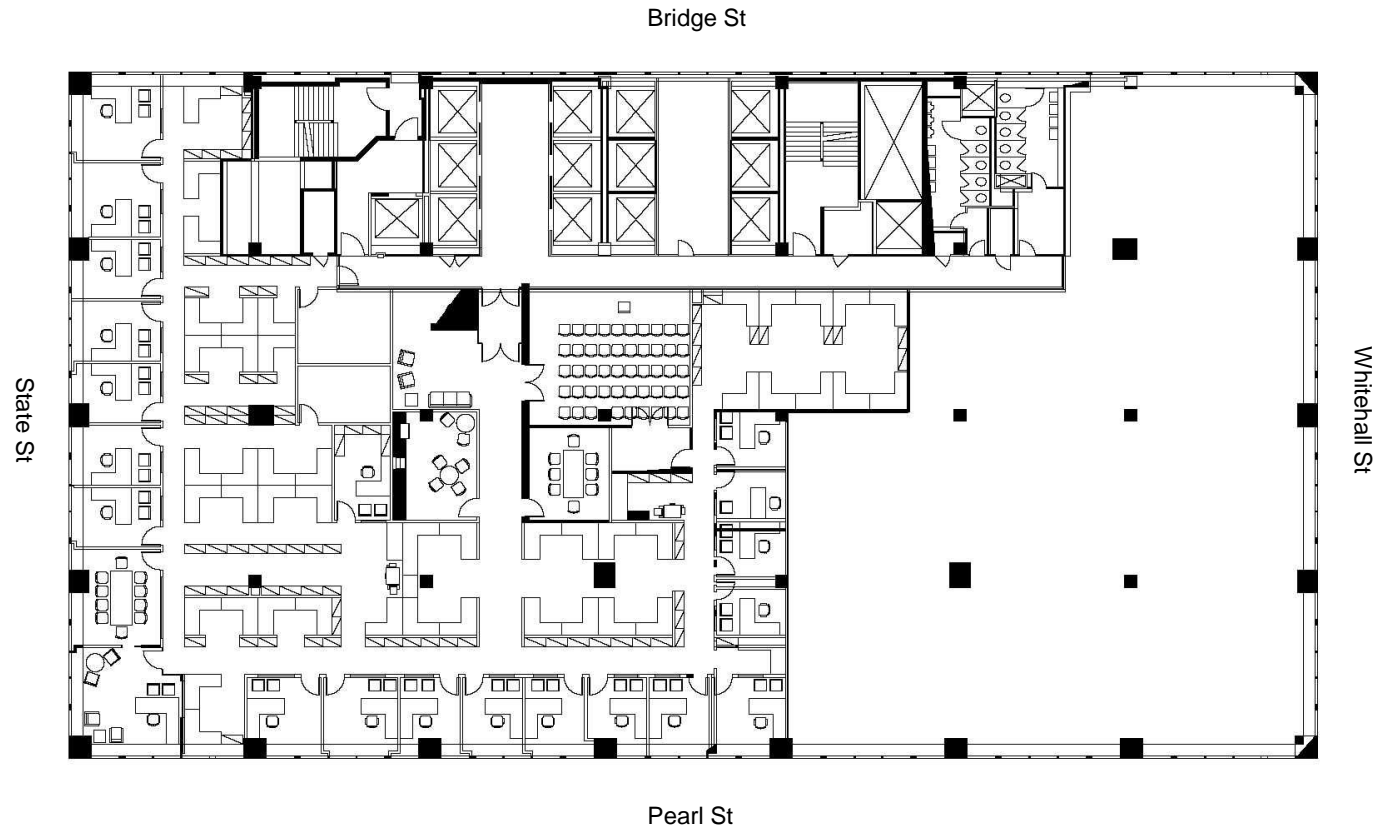

Kevin Daly

Thomas M. Keating

212.407.2437  
kdaly@rudin.com

212.407.2481  
tkeating@rudin.com

rudin.com

