


One Battery Park Plaza

Floor 29
As Built Plan

9,880 Sq. Ft.
Partial Floor Available
December 2021

Rudin

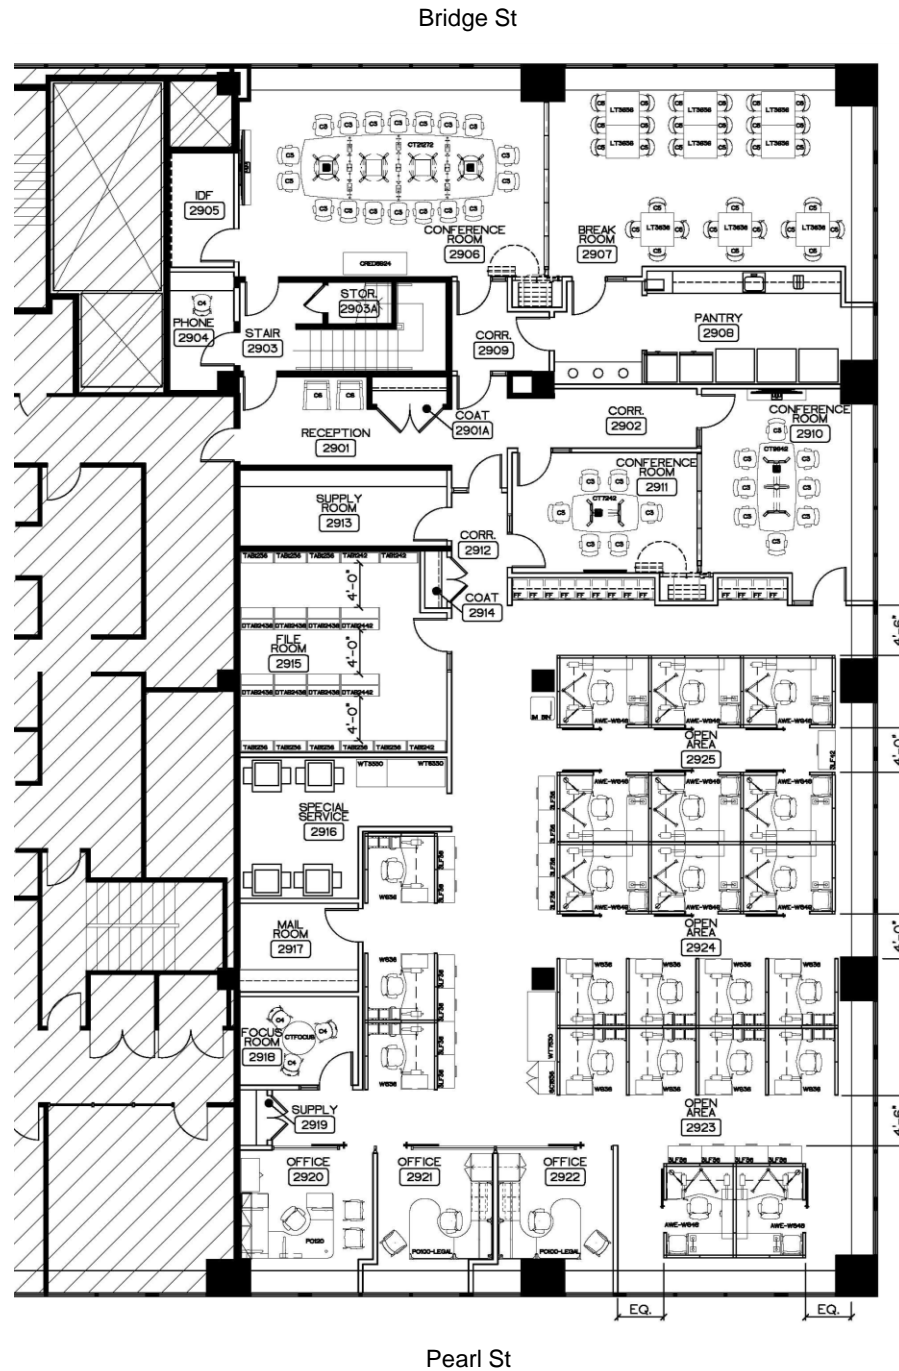

Kevin Daly

Thomas M. Keating

212.407.2437
kdaly@rudin.com

212.407.2481
tkeating@rudin.com

rudin.com