

ONE BATTERY PARK PLAZA

Floor 6
8,289 Sq. Ft.
As Built Plan


Partial Floor Available
November 1, 2025

Kevin Daly

212.407.2437
kdaly@rudin.com

rudin.com

RUDIN

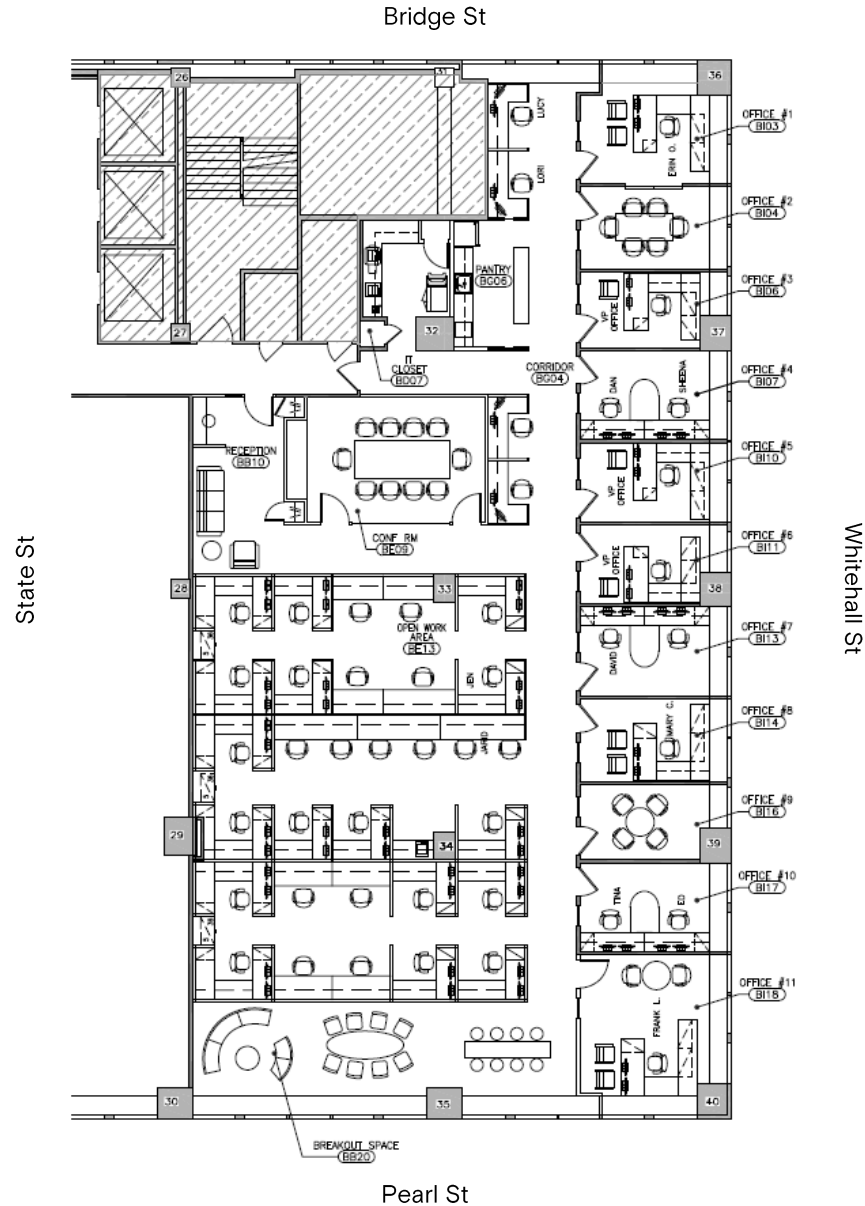

REBNY