

# 295 CENTRAL PARK WEST

AT WEST 90<sup>TH</sup> STREET


**Partial Ground - Suite 5**  
**670 Sq. Ft.**  
**As Built Plan**

**Kevin Daly**

212.407.2437  
kdaly@rudin.com

[rudin.com](http://rudin.com)

**RUDIN**

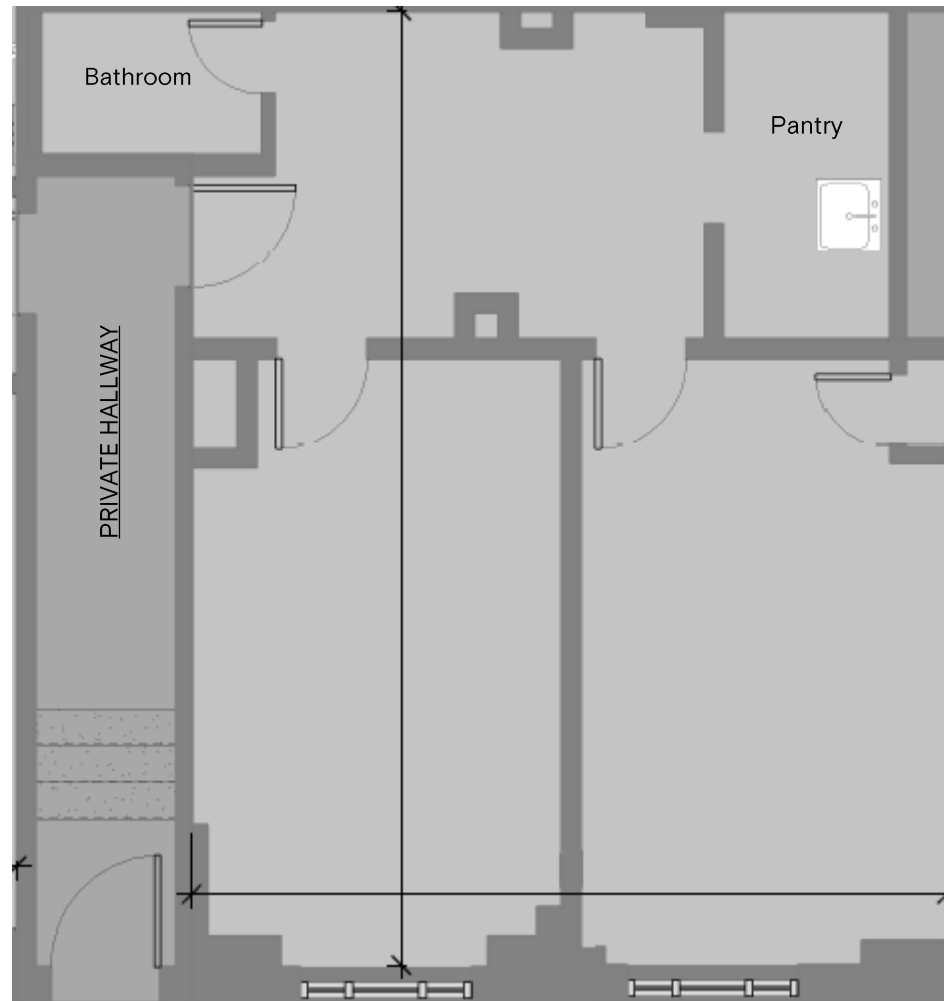

Central Park West



REBNY