

32 Avenue of the Americas

Two Full Floors
Available

Robert Steinman

212.407.2490
rsteinman@rudin.com

rudin.com



Rudin

32 Avenue of the Americas

16th Floor
As Built Floor Plan

46,812 Sq. Ft.
Full Floor Available
September 2020

13th Floor
As Built Floor Plan



52,518 Sq. Ft.
Full Floor Available
September 2020

Robert Steinman

212.407.2490
rsteinman@rudin.com

rudin.com

Rudin

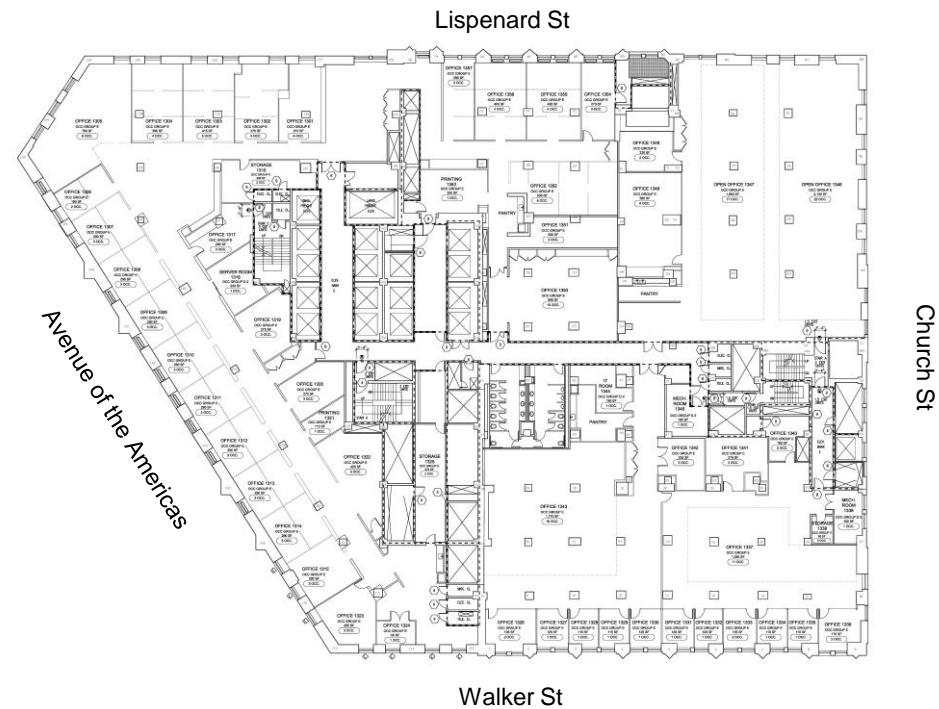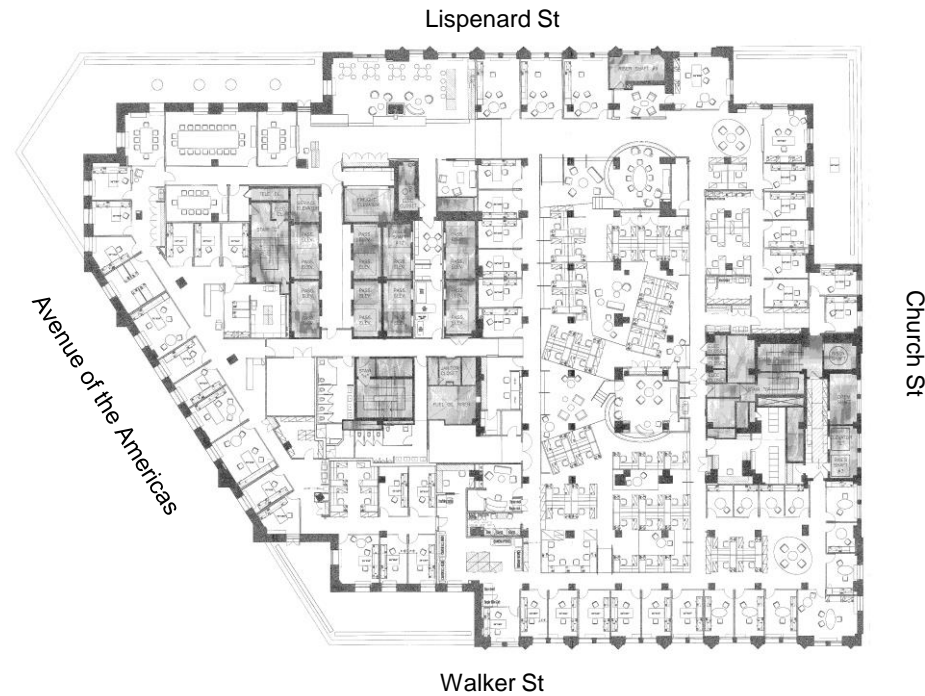

REBNY