


# 32 Avenue of the Americas

Rudin

18<sup>th</sup> Floor  
As Built Plan

45,041 Sq. Ft.  
Full Floor Available  
February 2022

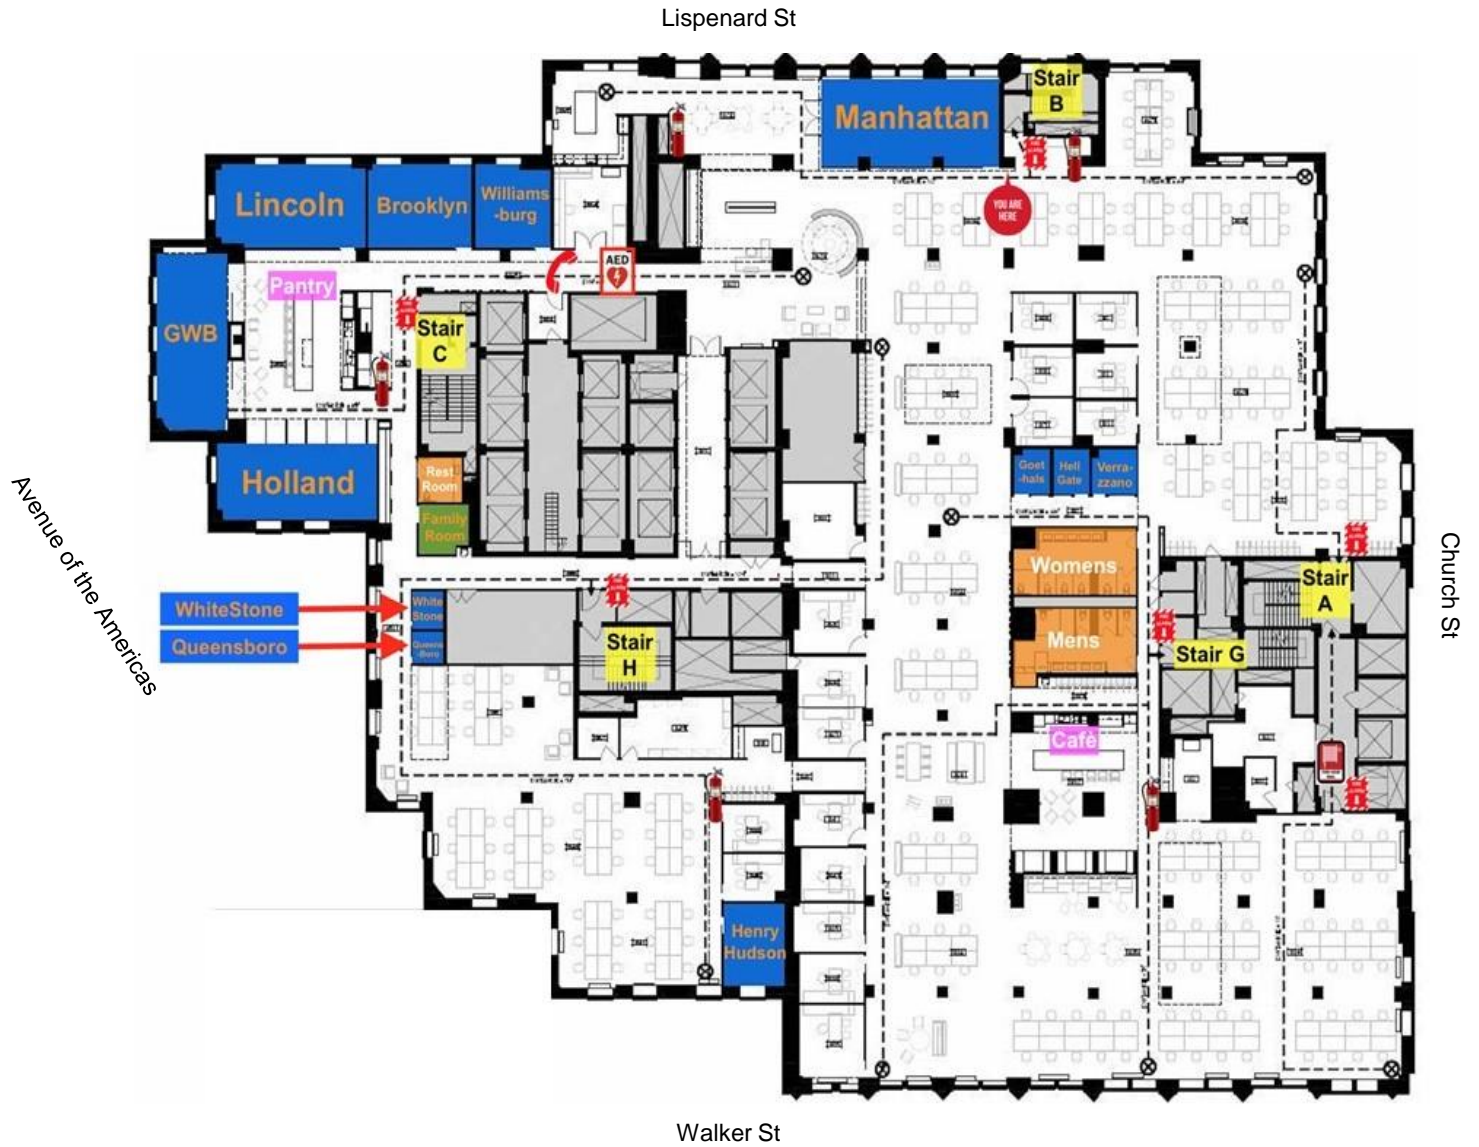

Robert Steinman

212.407.2490  
rsteinman@rudin.com

rudin.com