
32 Avenue of the Americas

19th Floor As Built Plan

45,021 Sq. Ft. Full Floor Available December 2021

Rudín

Lispenard St

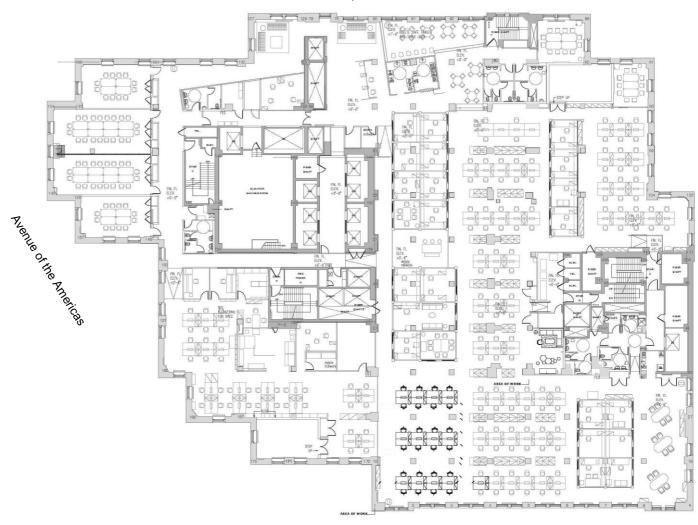

Walker St

Robert Steinman

212.407.2490 rsteinman@rudin.com

