


32 Avenue of the Americas

Rudin

6th Floor
As Built Plan

52,646 Sq. Ft.
Full Floor Available
Immediately

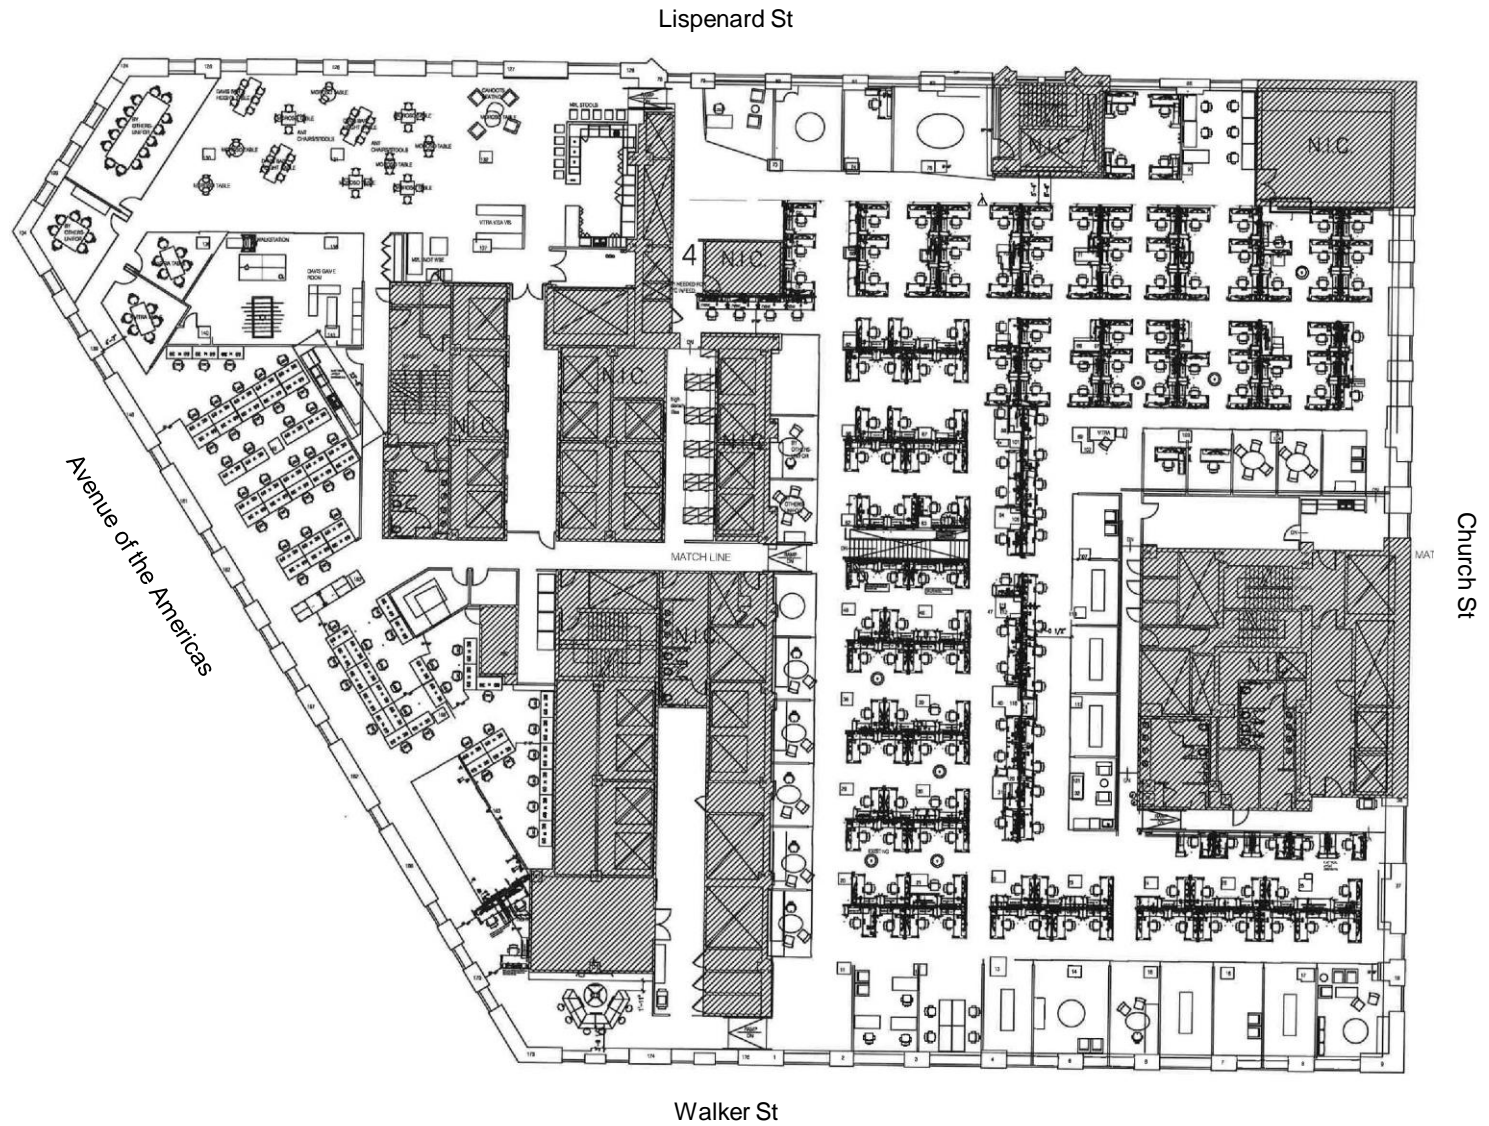

Robert Steinman

212.407.2490
rsteinman@rudin.com

rudin.com