


32 Avenue of the Americas

Lispenard St

17th Floor As-Built Plan

7,485 Sq. Ft. Partial Floor Available December 2023

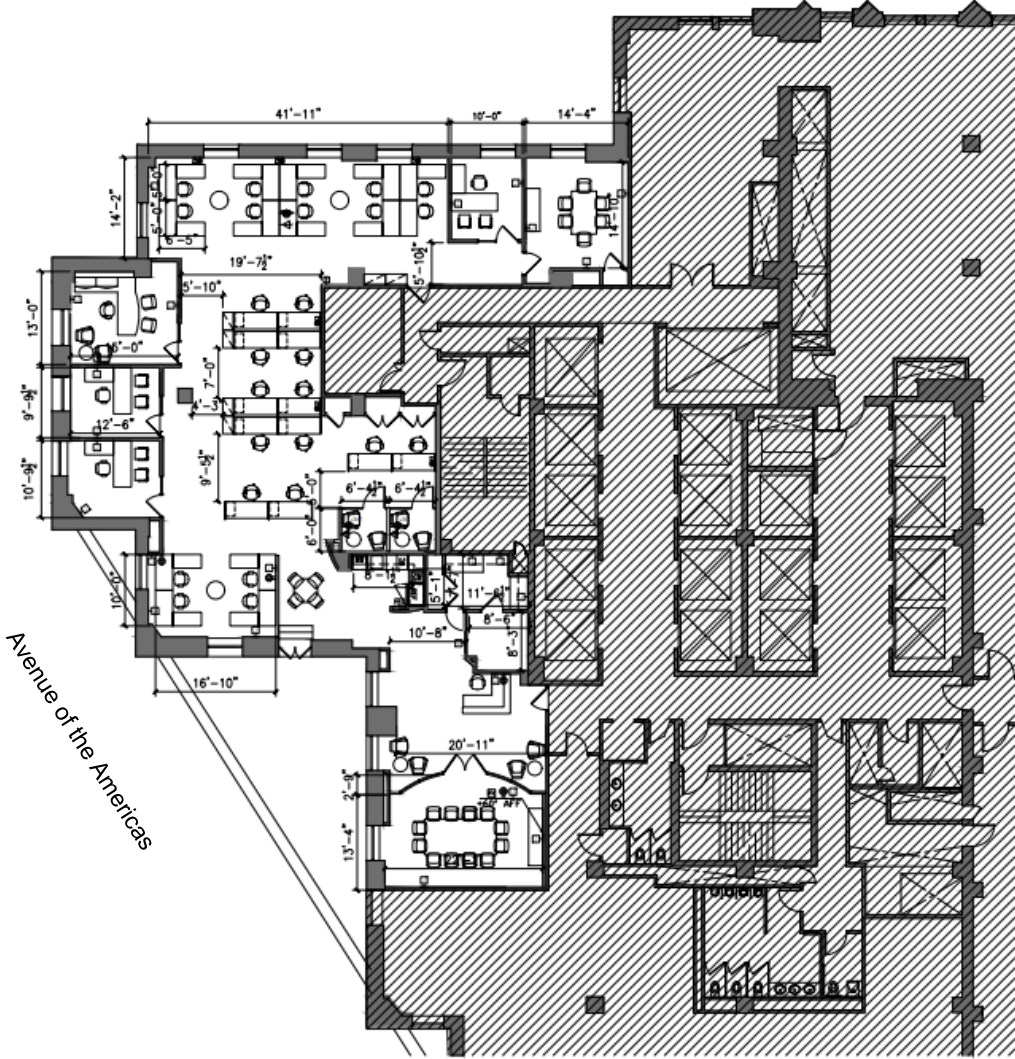

Robert Steinman

212.407.2490
rsteinman@rudin.com

rudin.com

Walker St

Church St