

32 Avenue of the Americas


17th Floor
As Built Plan

21,554 Sq. Ft.
Partial Floor Available
February 2022

*Additional 10,752 Sq. Ft. of
contiguous space available.

Rudin

Lispenard St

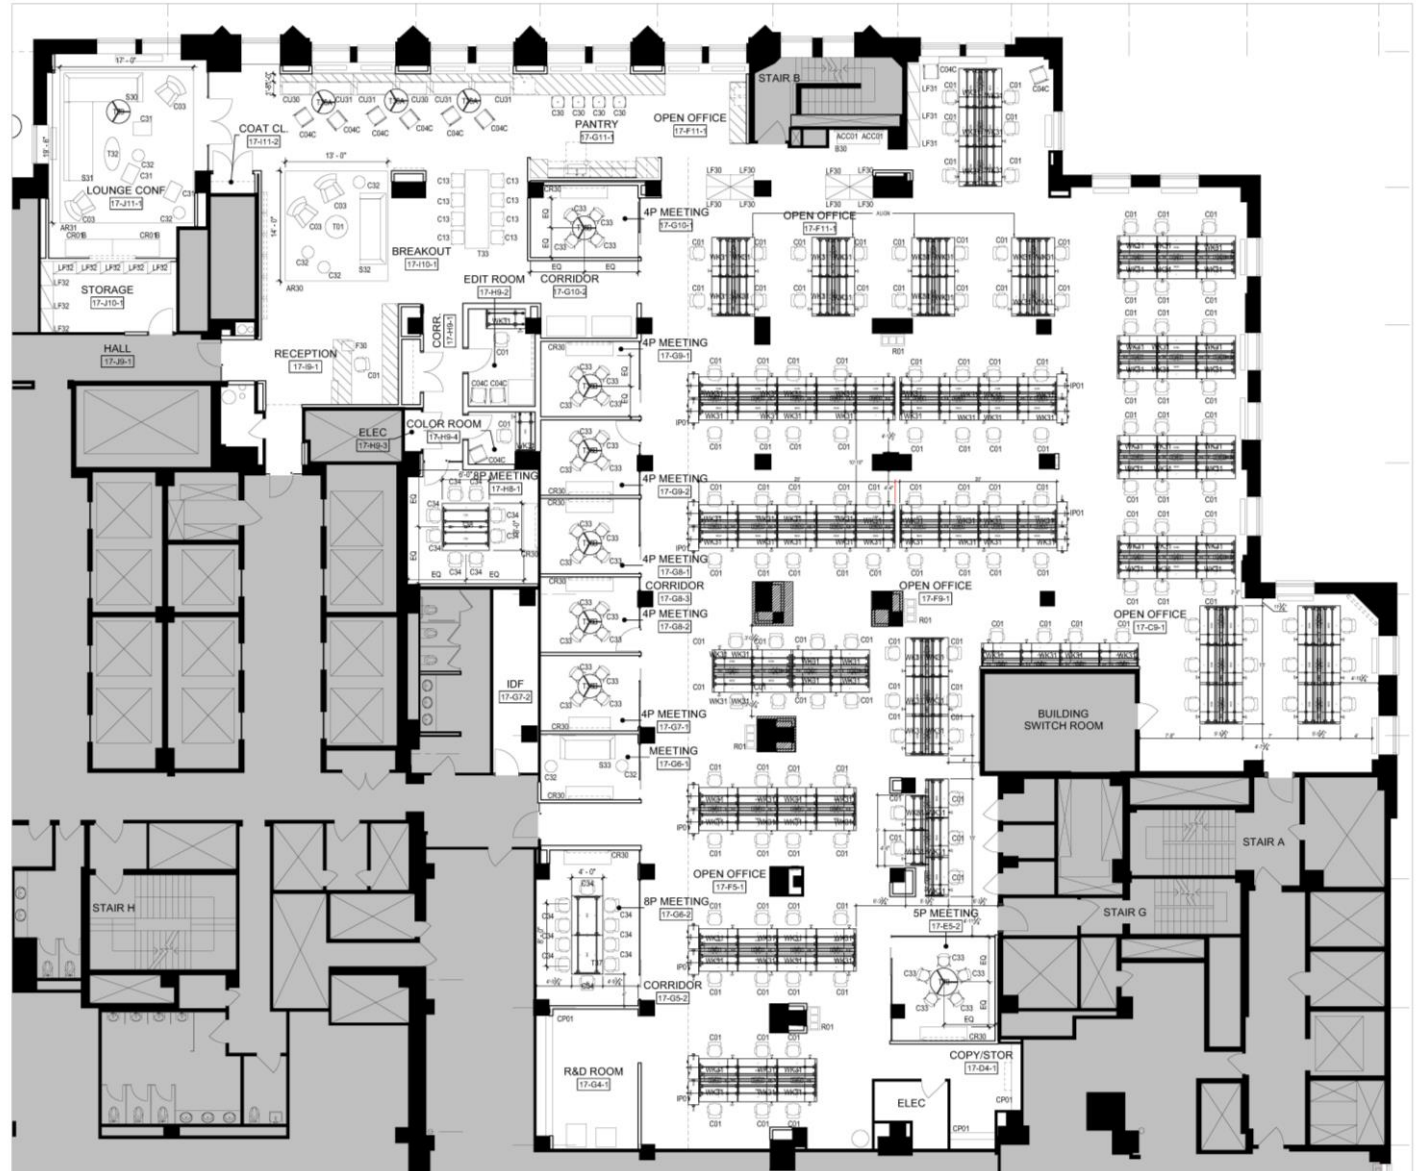

Church St

Robert Steinman

212.407.2490
rsteinman@rudin.com

rudin.com