


32 Avenue of the Americas

21st Floor
As-Built Plan

9,088 Sq. Ft.
Partial Floor Available
Immediately

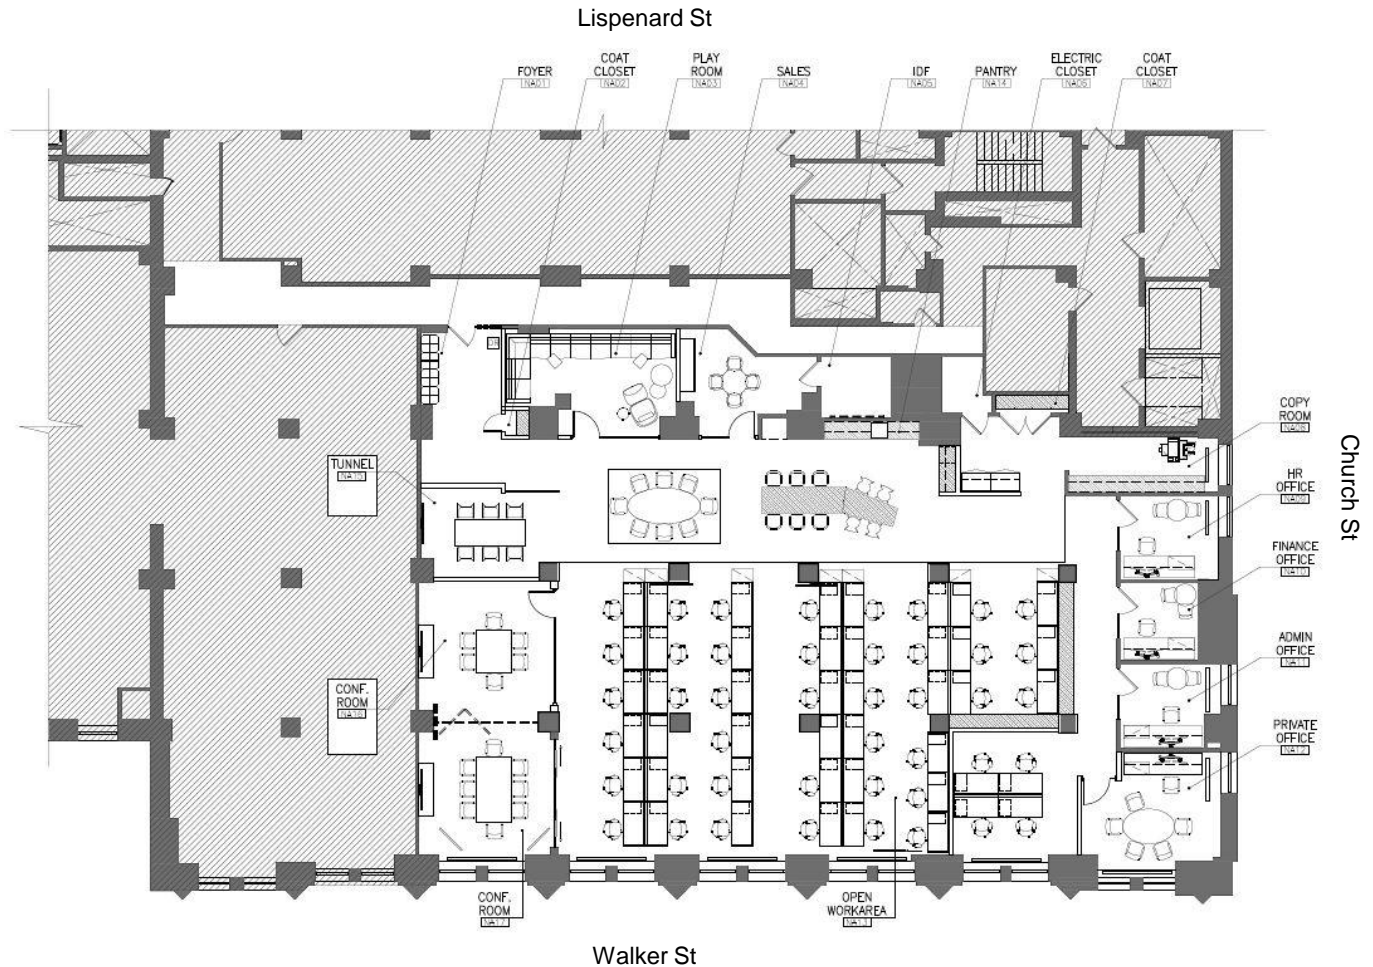

Robert Steinman

212.407.2490
rsteinman@rudin.com