


32 Avenue of the Americas

27th Floor
As Built Plan

5,148 Sq. Ft.
Partial Floor Available
Immediately

Avenue of the Americas

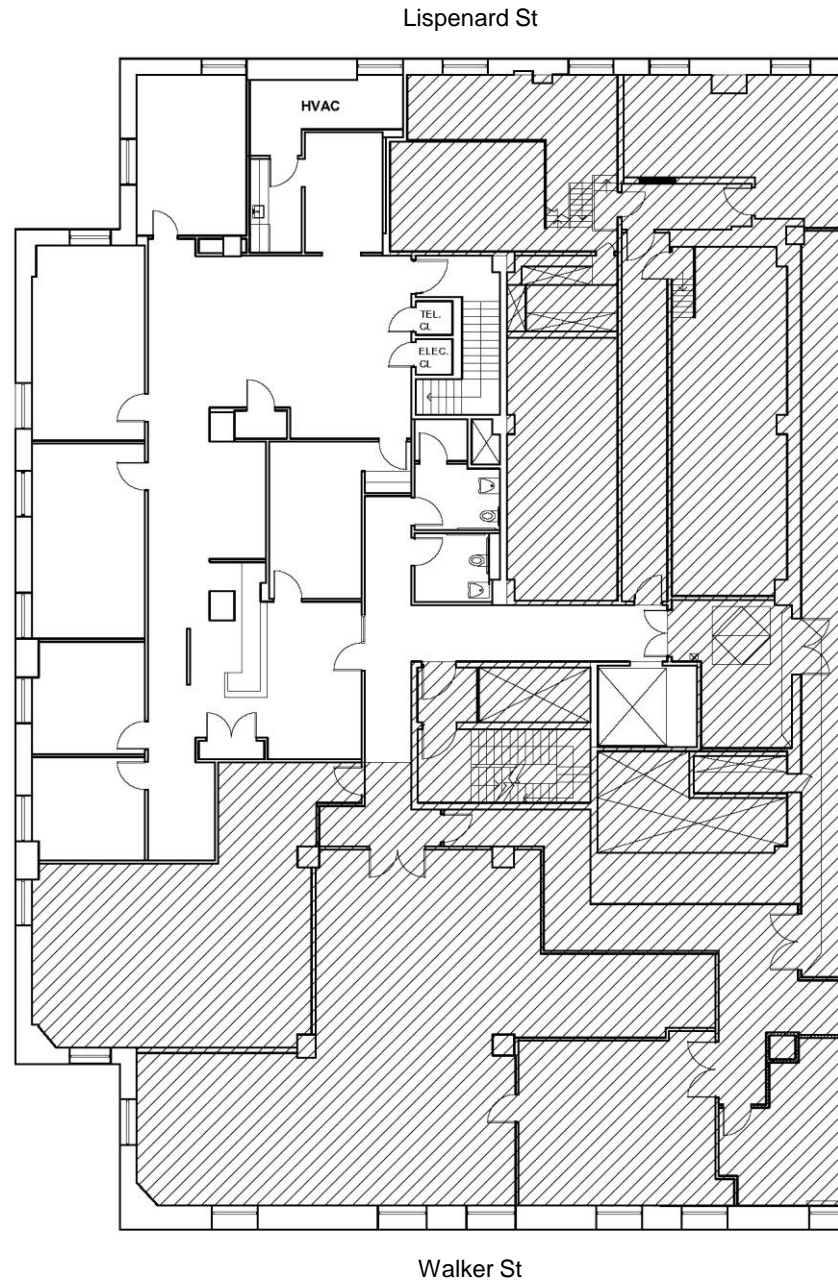

Robert Steinman

212.407.2490
rsteinman@rudin.com

rudin.com

Rudin