


355 Lexington Avenue

Rudin

Floor 22
As Built Plan

4,336 Sq. Ft.
Full Floor Available
Immediately

Asking \$59 per RSF

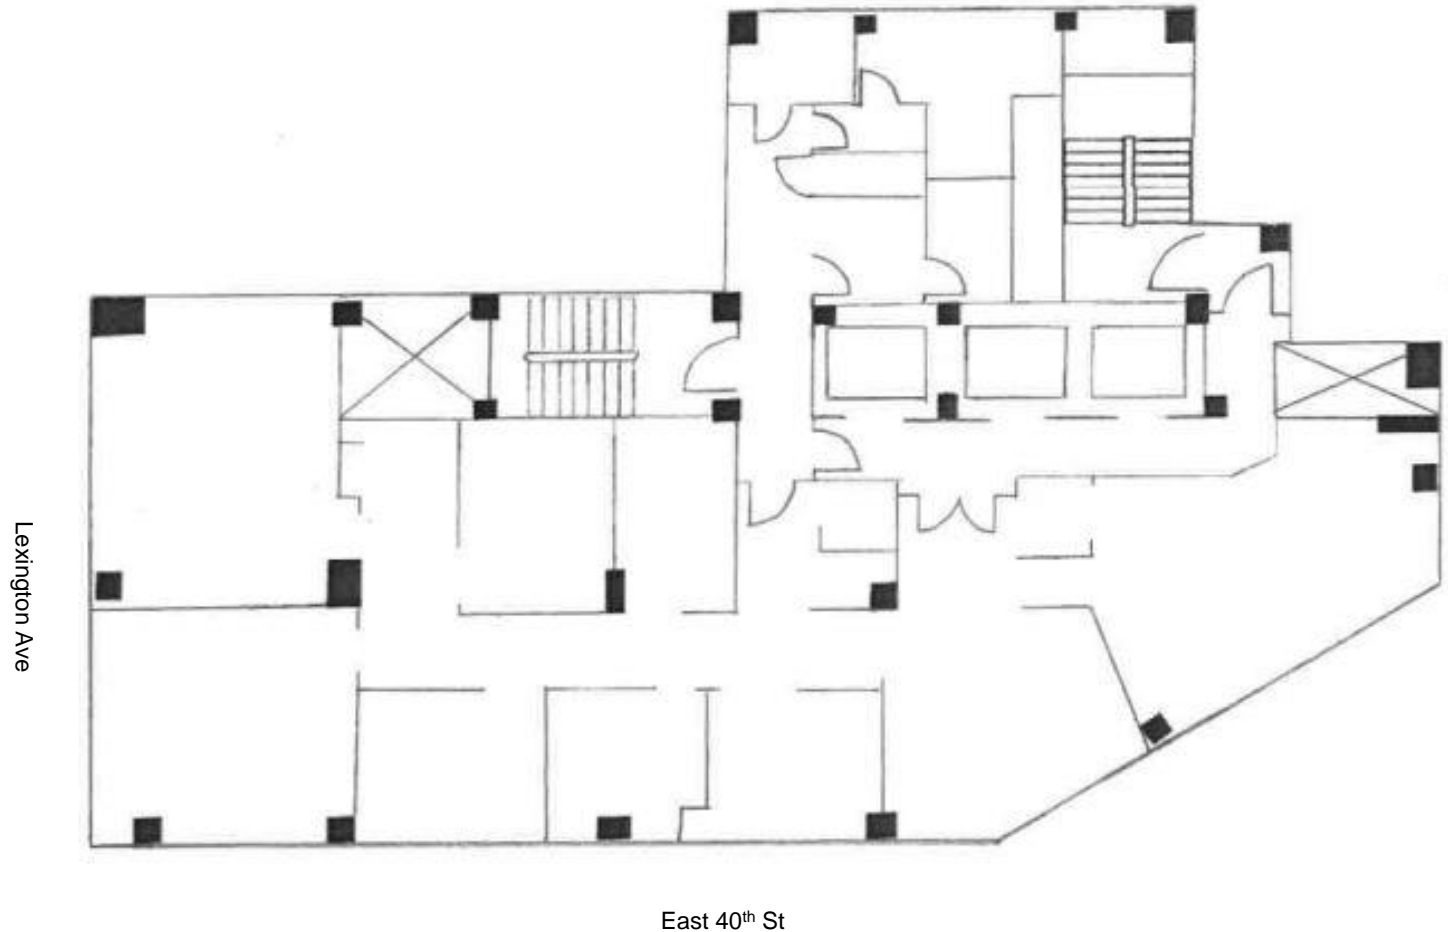

Robert Steinman

212.407.2490
rsteinman@rudin.com

rudin.com