


355 Lexington Avenue

Rudin

Floor 7
As Built Plan

17,485 Sq. Ft.
Entire Floor Available

New Law Firm Installation

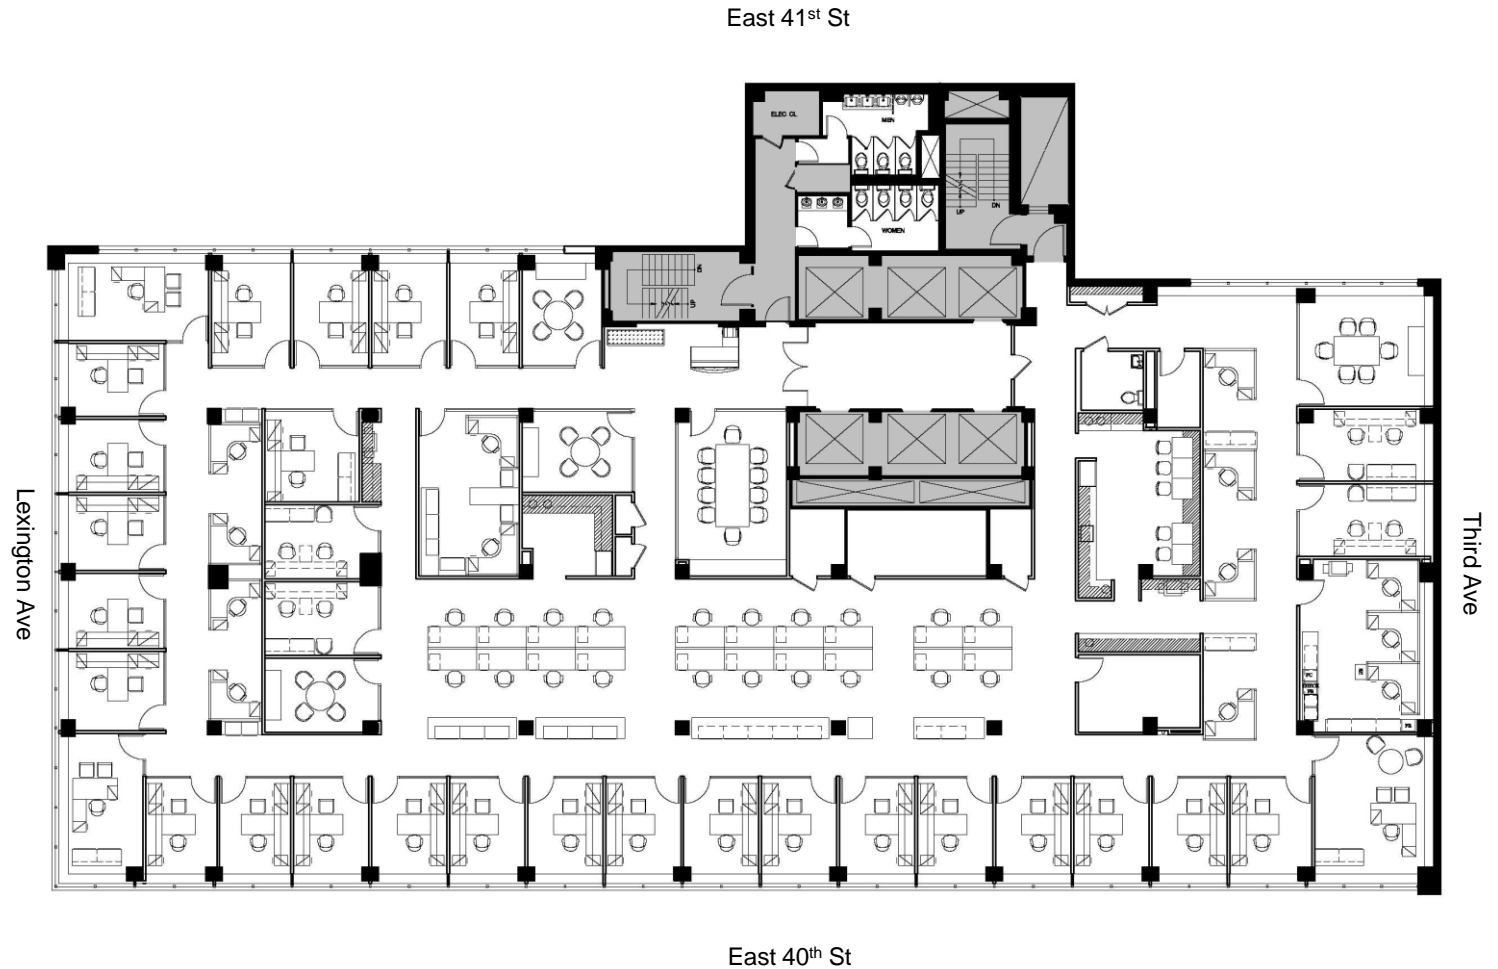

Robert Steinman

212.407.2490
rsteinman@rudin.com

rudin.com