


# 355 Lexington Avenue

Rudin

Floor 10  
As Built Plan

2,915 Sq. Ft.  
Partial Floor Available

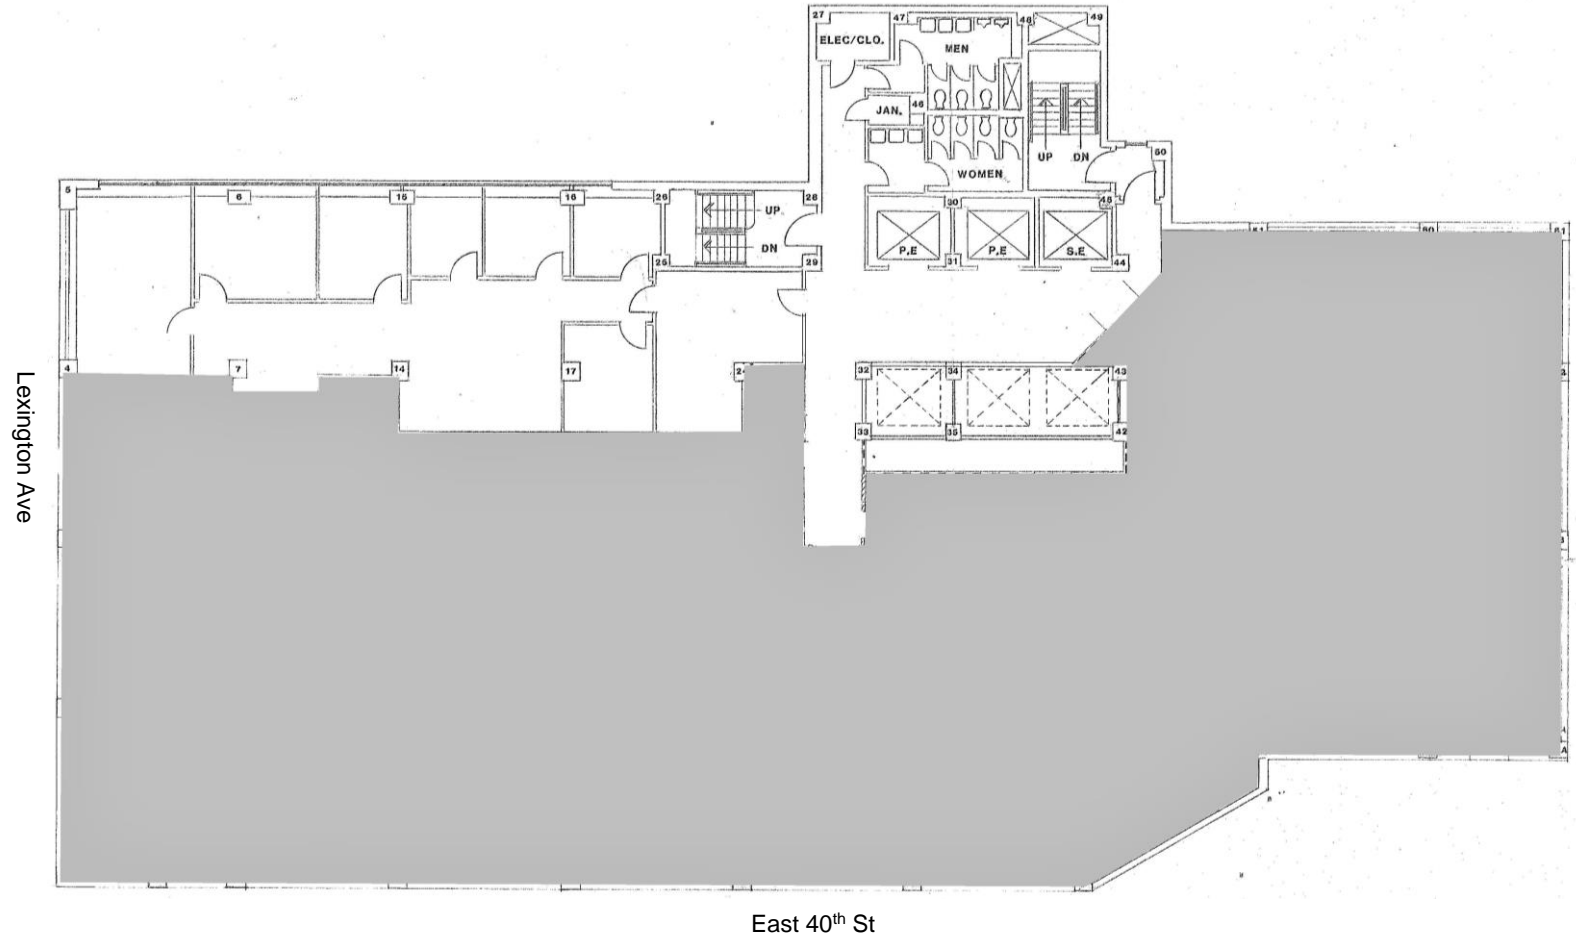

Robert Steinman

212.407.2490  
rsteinman@rudin.com

[rudin.com](http://rudin.com)