


355 Lexington Avenue

Rudin

Floor 14
As Built Plan

1,904 Sq. Ft.
Partial Floor Available

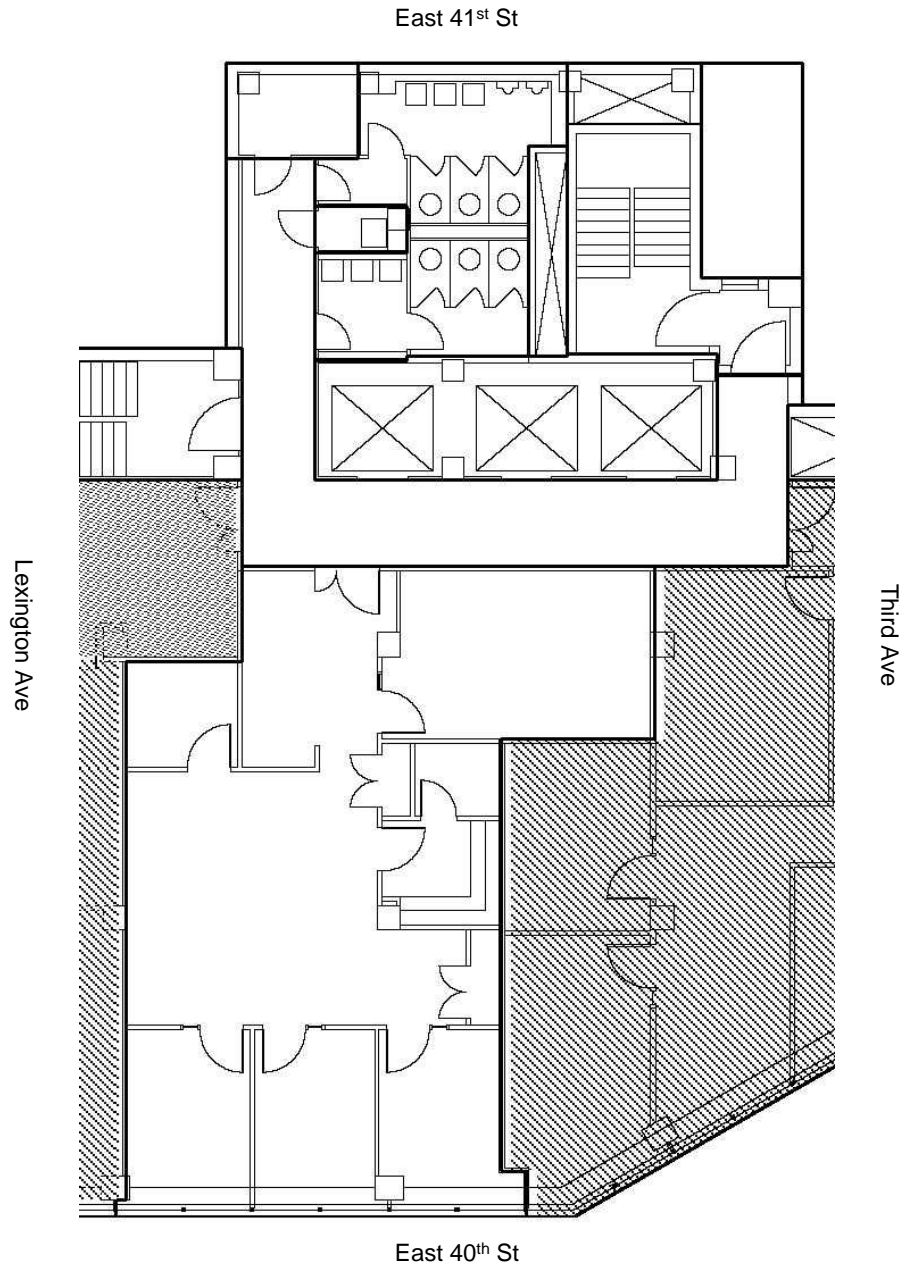

Robert Steinman

212.407.2490
rsteinman@rudin.com

rudin.com