


355 Lexington Avenue

Rudin

Floor 3
As Built Plan

8,397 Sq. Ft.
Partial Floor Available
Possession Arranged

Asking: \$55 per RSF
Furniture Available

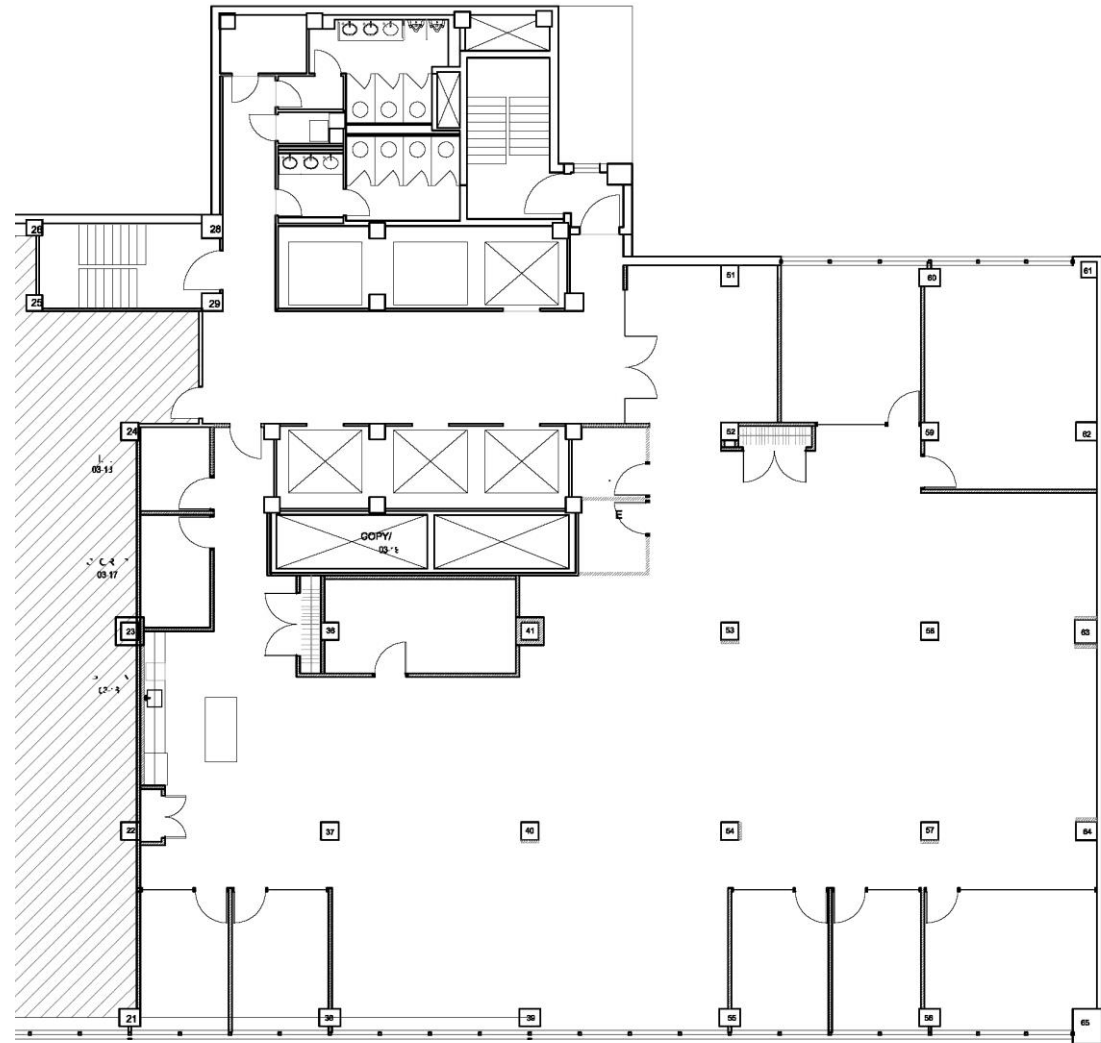

East 40th St

Robert Steinman

212.407.2490
rsteinman@rudin.com

rudin.com