


355 Lexington Avenue

Rudin

Floor 8
As Built Plan

5,741 Sq. Ft.
Partial Floor Available

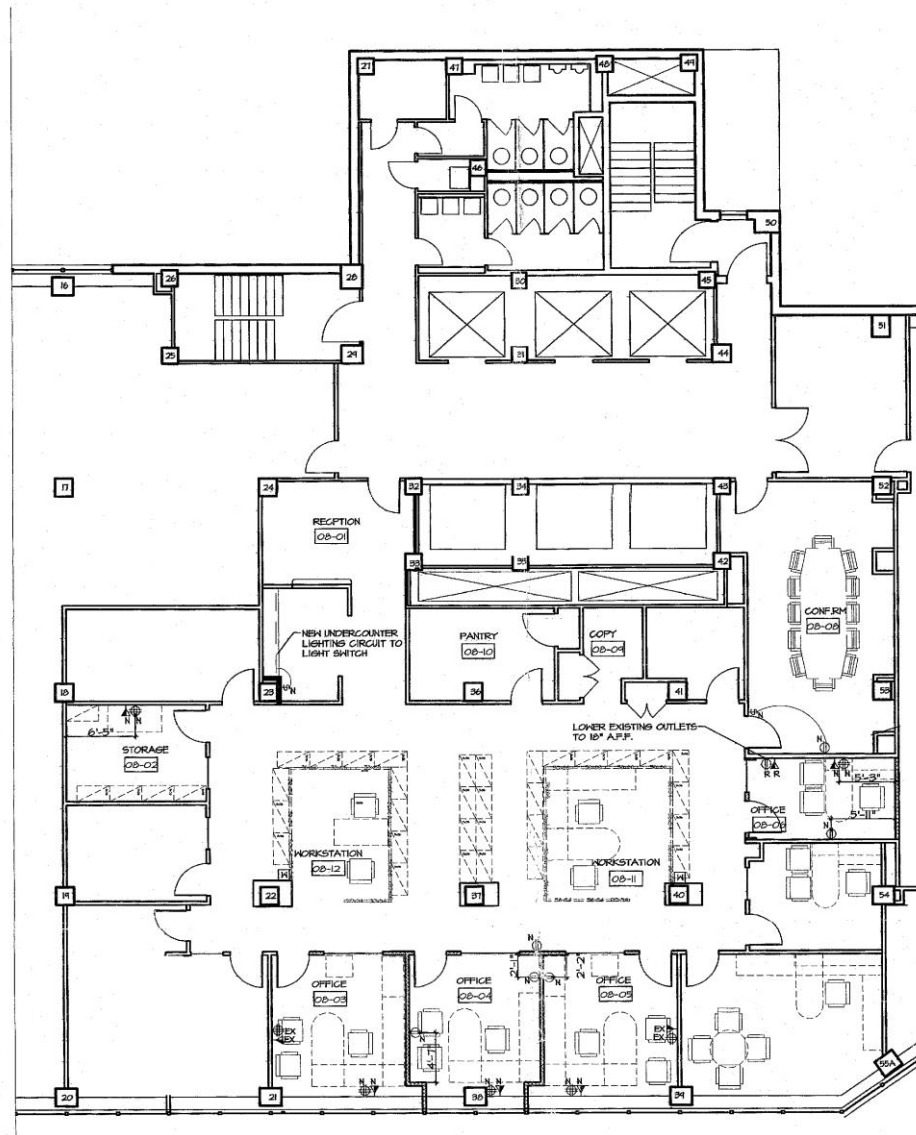

East 40th St

Robert Steinman

212.407.2490
rsteinman@rudin.com

rudin.com