


355 Lexington Avenue

Rudin

Floor 4
As Built Plan

2,873 Sq. Ft.
Partial Floor Available

Asking \$55 per RSF

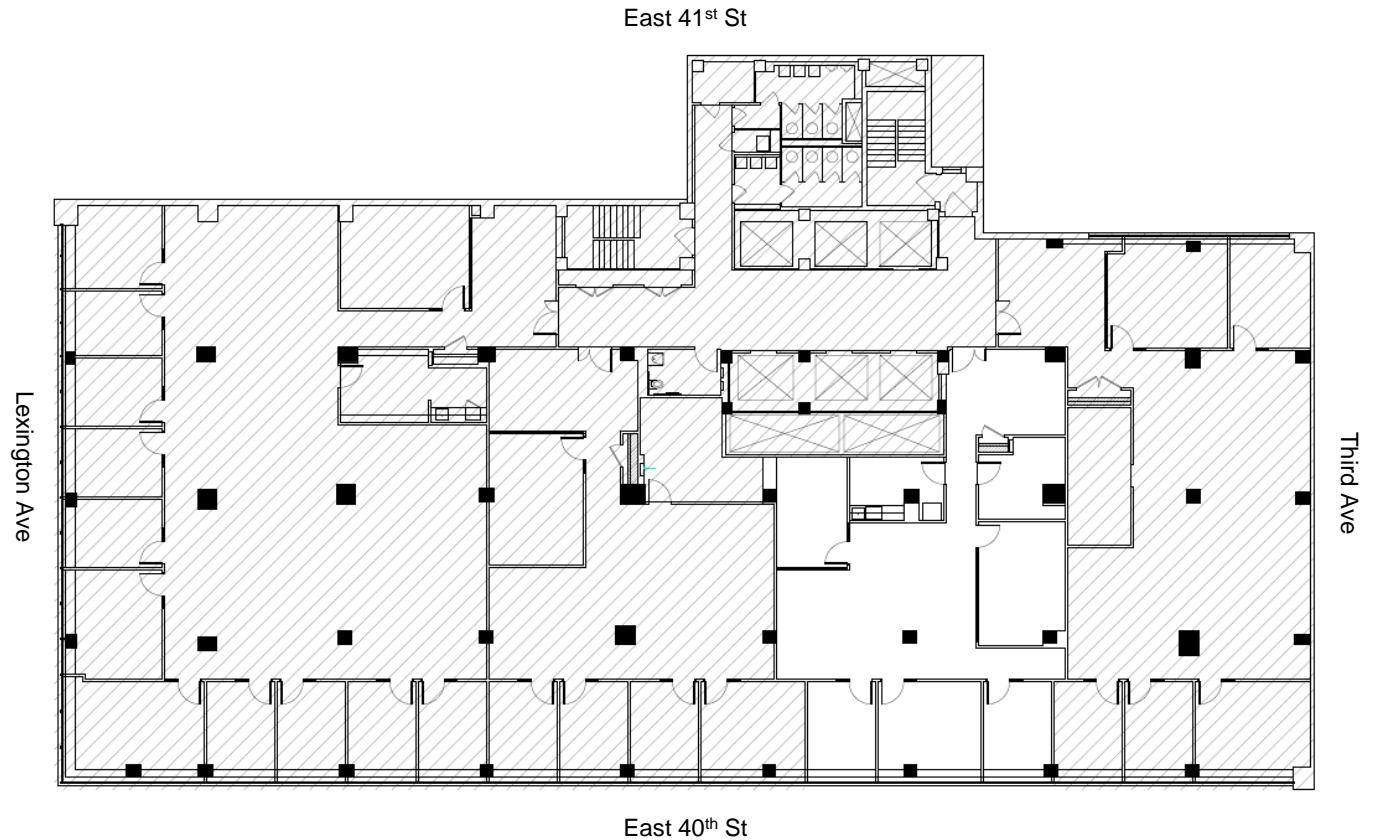

Robert Steinman

212.407.2490
rsteinman@rudin.com

rudin.com



REBNY