


4 | MADISON

RUDIN

Floor 20
As Built Floor Plan

8,205 Sq. Ft.
Partial Floor Available
January 1, 2026

Asking \$89 per RSF

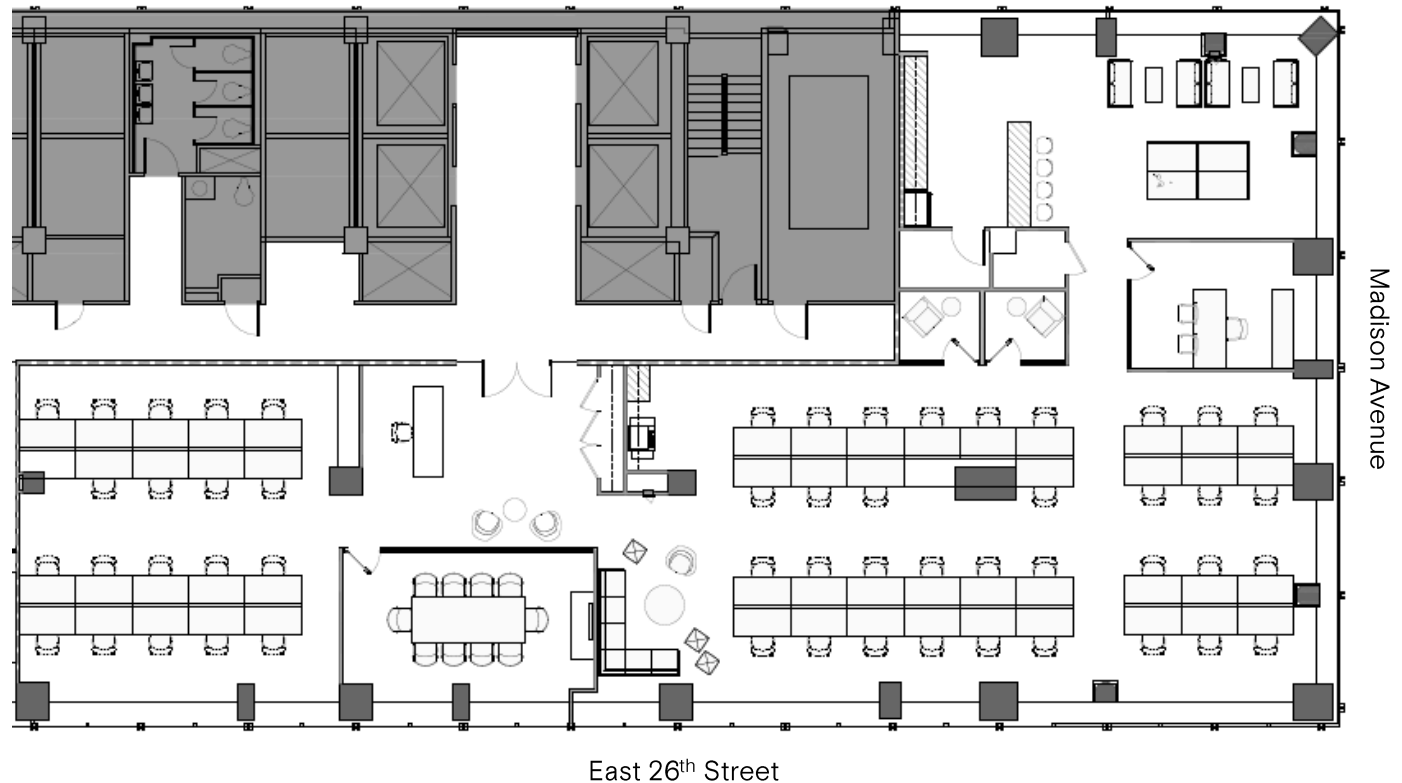

Robert Steinman

212.407.2490
rsteinman@rudin.com

rudin.com



REBNY