


Floor 33 As Built Floor Plan

9,096 Sq. Ft.
Partial Floor Available
August 1, 2025

Asking \$92 per RSF

Madison Avenue

East 26th Street

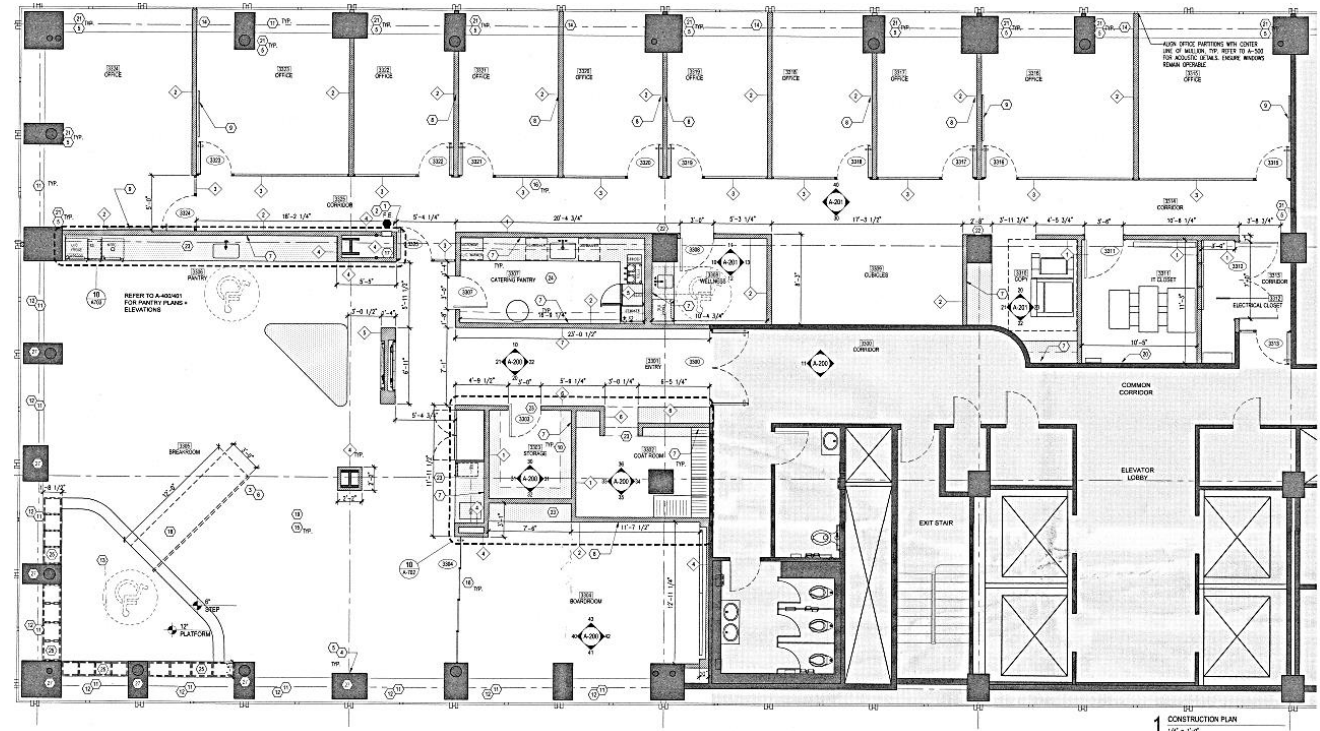

Robert Steinman

212.407.2490
rsteinman@rudin.com

rudin.com



REBNY