


Floor 33
As Built Plan
9,096 Sq. Ft.
Partial Floor Available

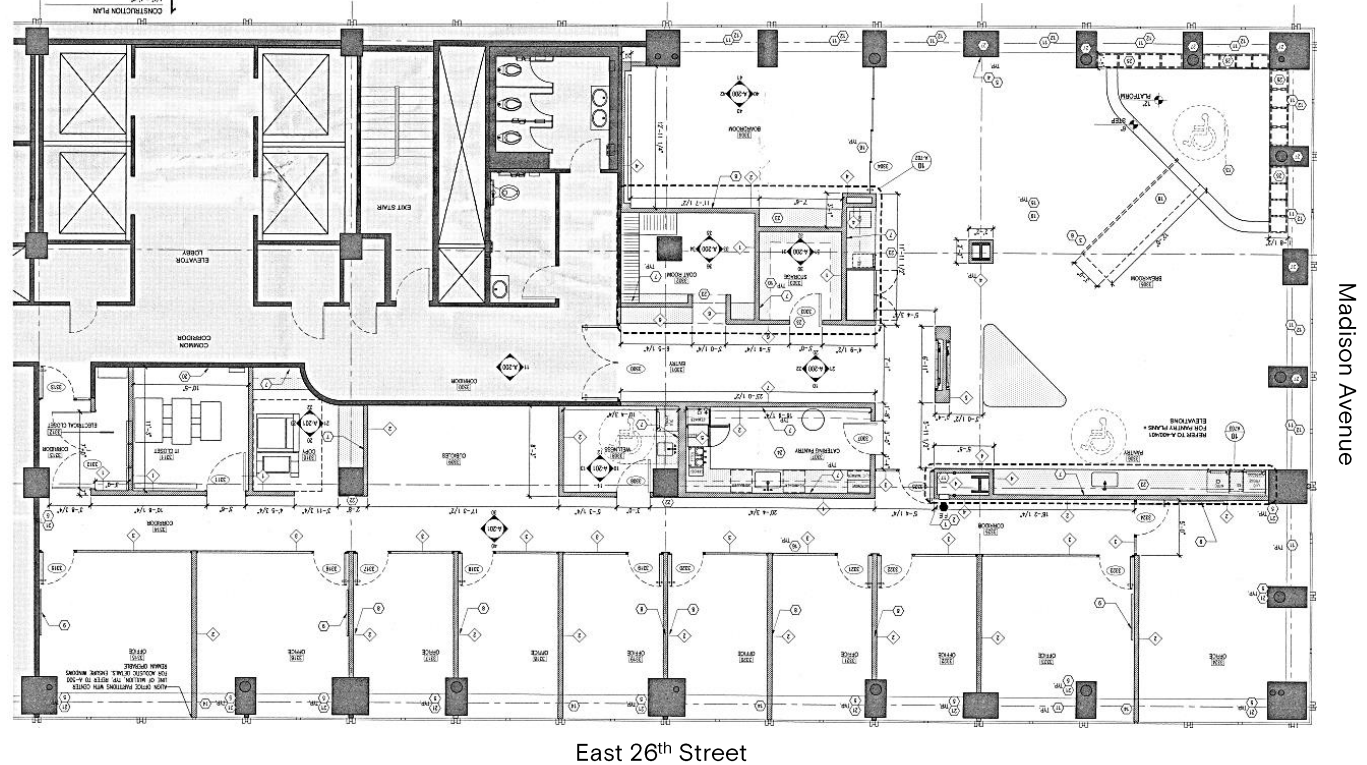

Robert Steinman

212.407.2490
 rsteinman@rudin.com

rudin.com



REBNY