

# 55 BROAD



Floor 13

As Built Plan

1,658 Sq. Ft.  
Partial Floor Available  
Immediately

---

Rudin

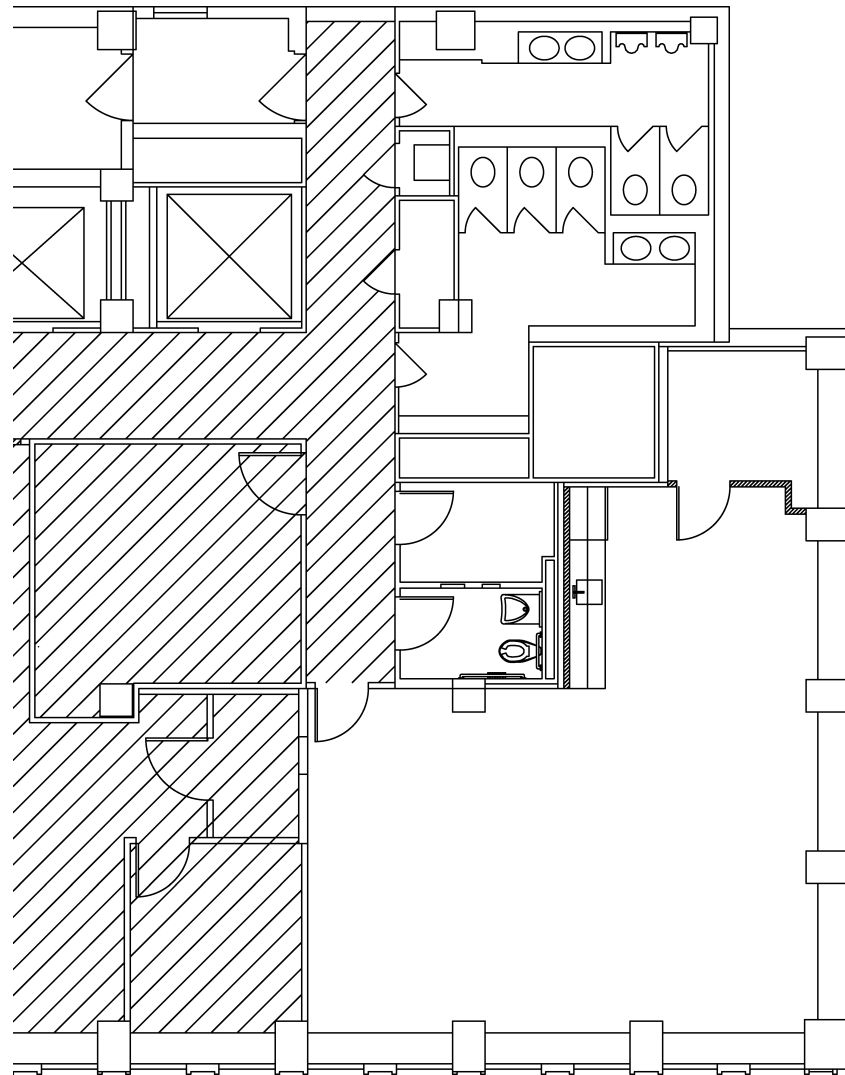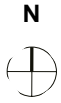

Beaver Street

Kevin Daly

Thomas M. Keating

212.407.2437  
kdaly@rudin.com

212.407.2481  
tkeating@rudin.com

[rudin.com](http://rudin.com)



REBNY