



# 55 BROAD

Floor 15  
As Built Plan

1,660 Sq. Ft.  
Partial Floor Available

---

Rudin

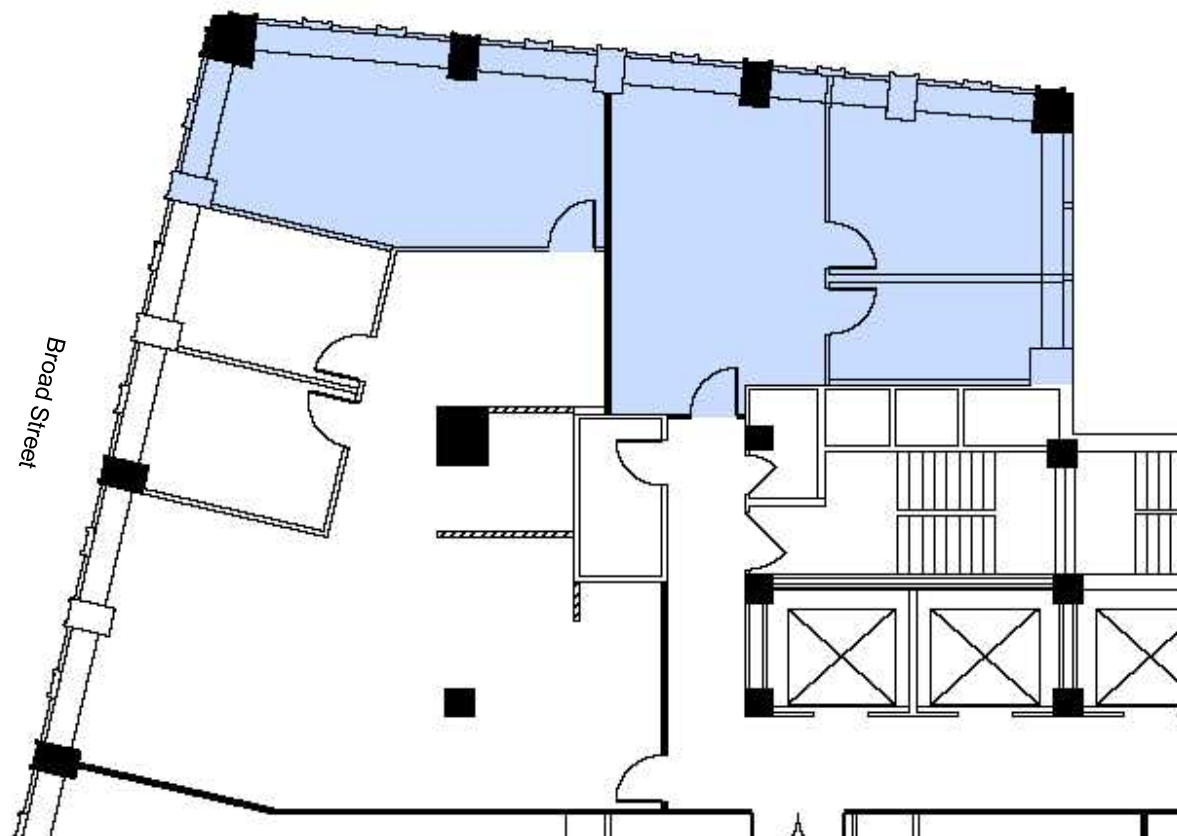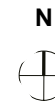

Kevin Daly

212.407.2437  
kdaly@rudin.com

Thomas M. Keating

212.407.2481  
tkeating@rudin.com

[rudin.com](http://rudin.com)



REBNY