


# 55 BROAD

Rudin

Floor 15  
As Built Plan

7,332 Sq. Ft.  
Partial Floor Available

---

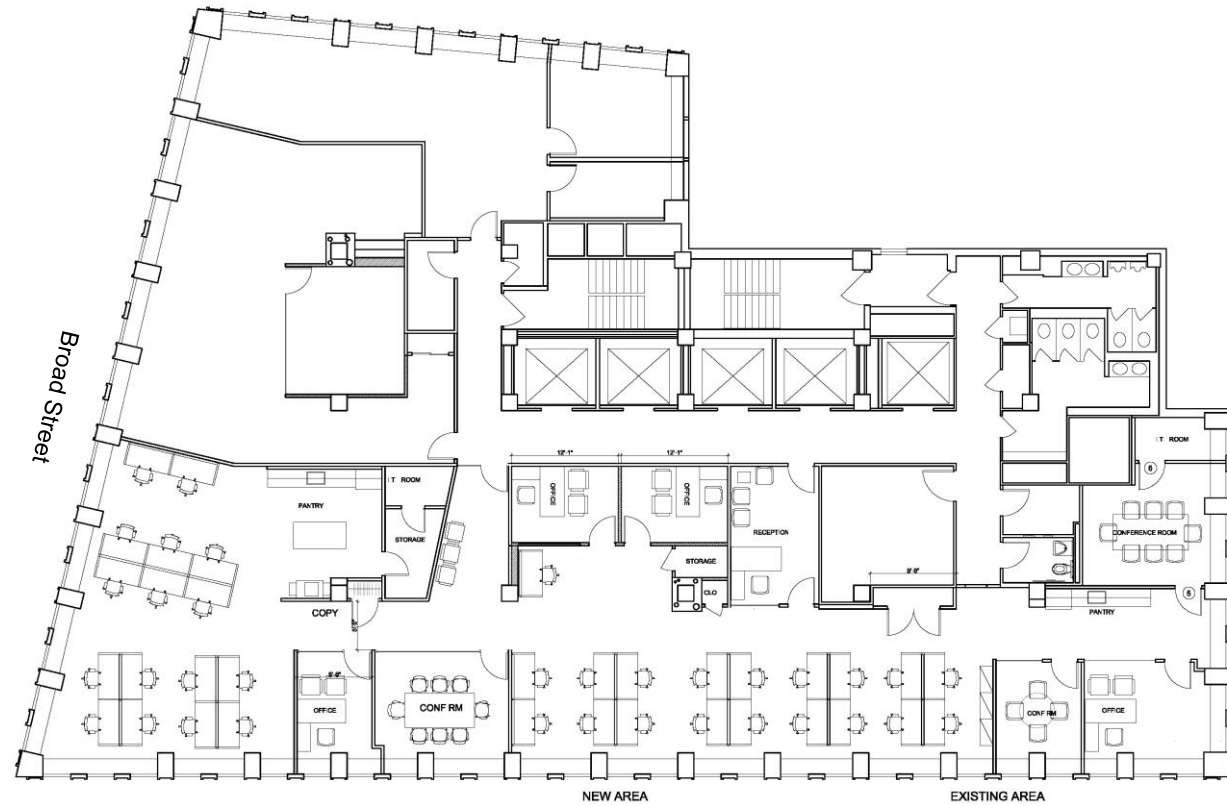

Kevin Daly

Thomas M. Keating

212.407.2437  
kdaly@rudin.com

212.407.2481  
tkeating@rudin.com

rudin.com



REBNY