

55 BROAD


Rudin



Floor 17

Existing Conditions
Plan

3,748 Sq. Ft.
Partial Floor
Available Immediately

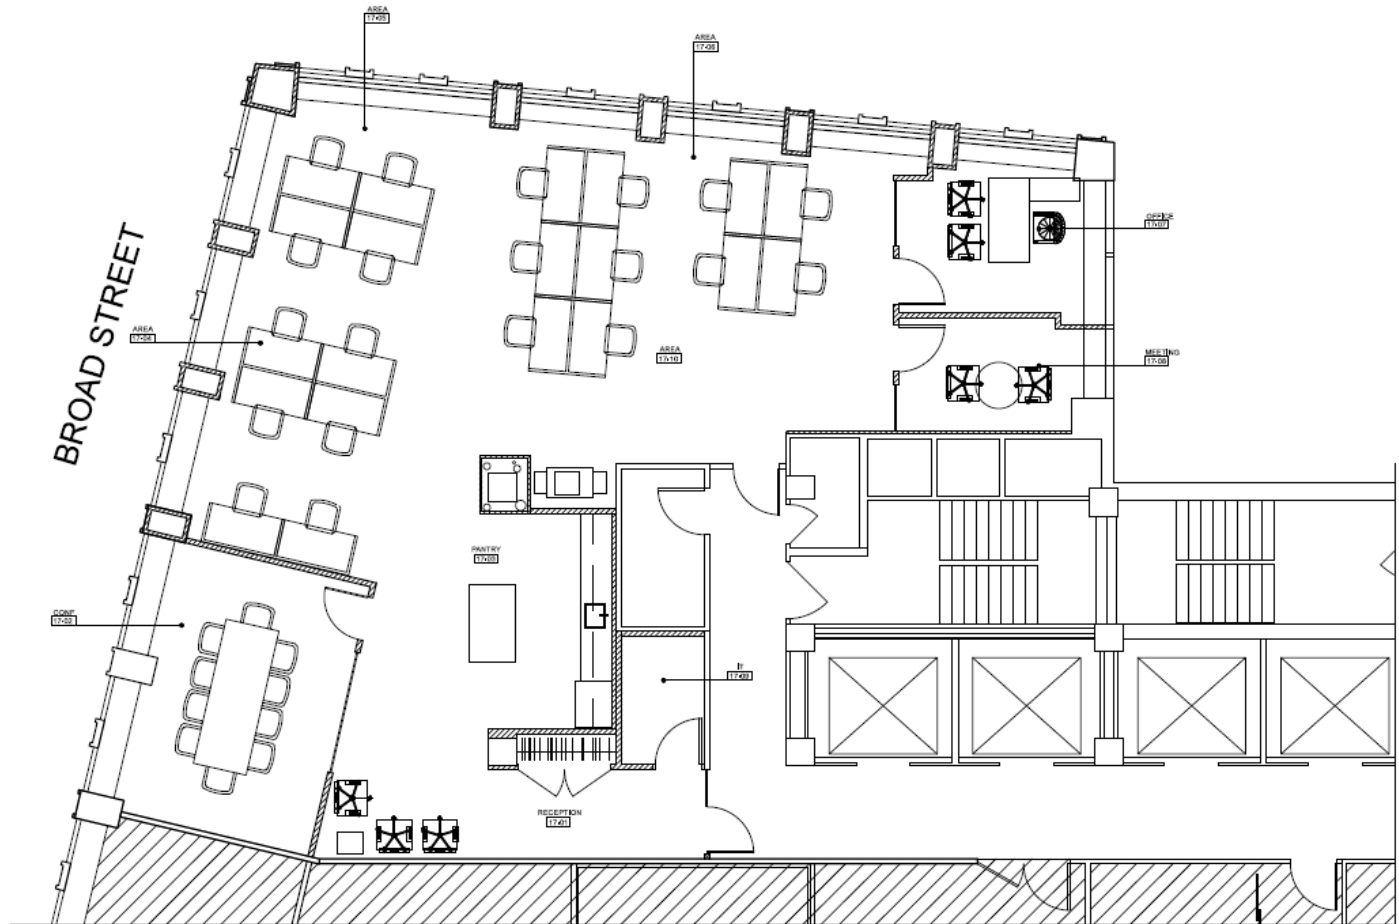

Kevin Daly

Thomas M. Keating

212.407.2437
kdaly@rudin.com

212.407.2481
tkeating@rudin.com

rudin.com

