

# 55 BROAD

Rudin




Floor 28

Existing Conditions  
Plan

1,051 Sq. Ft.  
Partial Floor Available  
Immediately

---

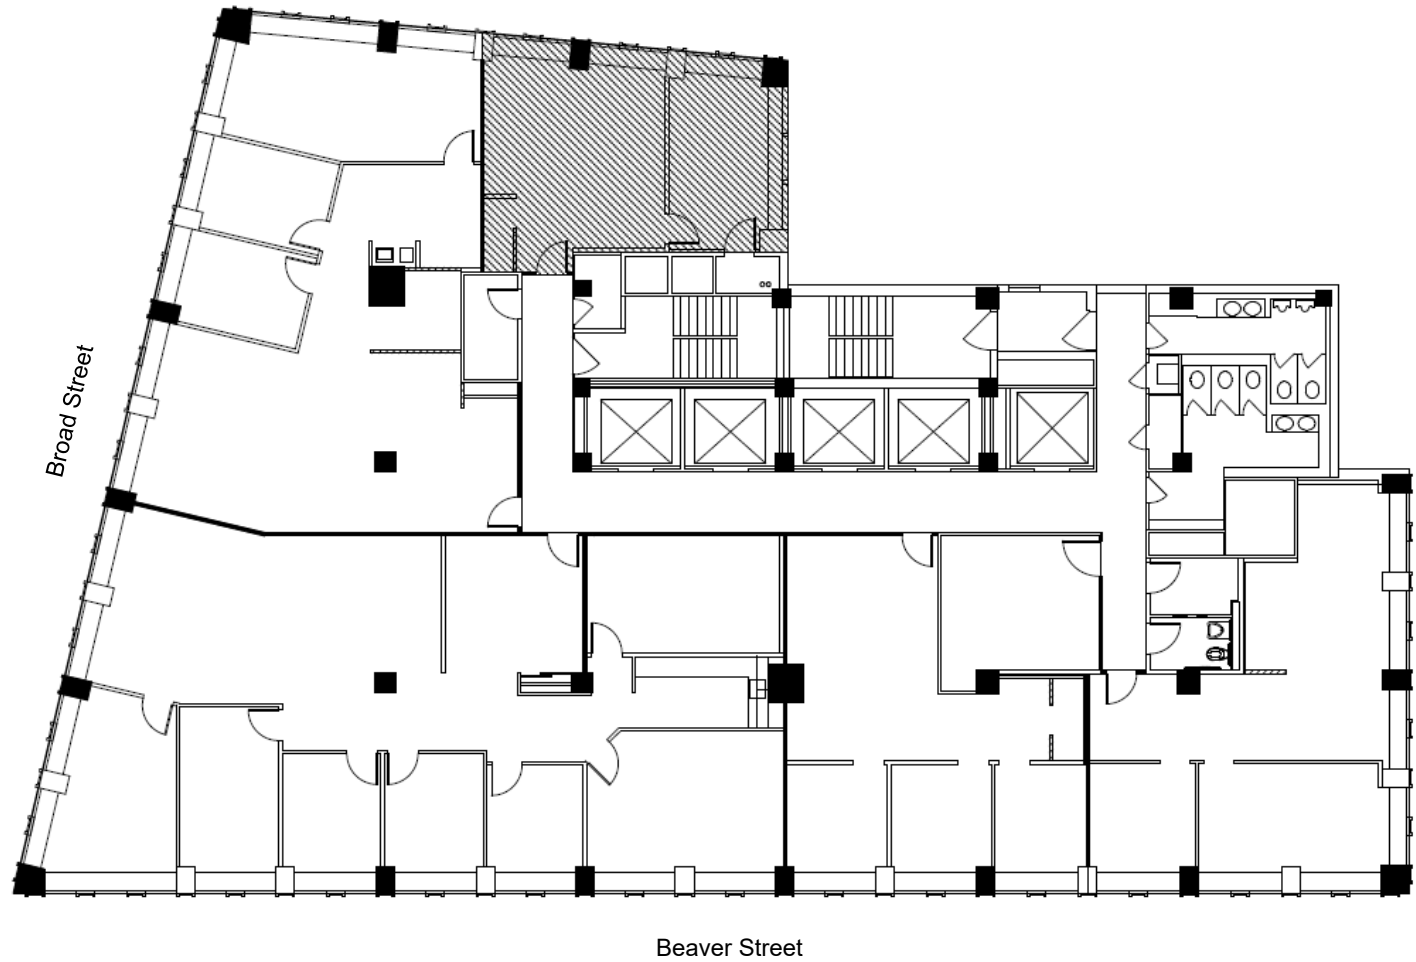

Kevin Daly

Thomas M. Keating

212.407.2437  
kdaly@rudin.com

212.407.2481  
tkeating@rudin.com

rudin.com



REBNY