


560 Lexington Avenue

Rudin

East 50th Street

Floor 14
As Built Floor Plan

16,772 Sq. Ft.
Entire Floor Available
January 1, 2024

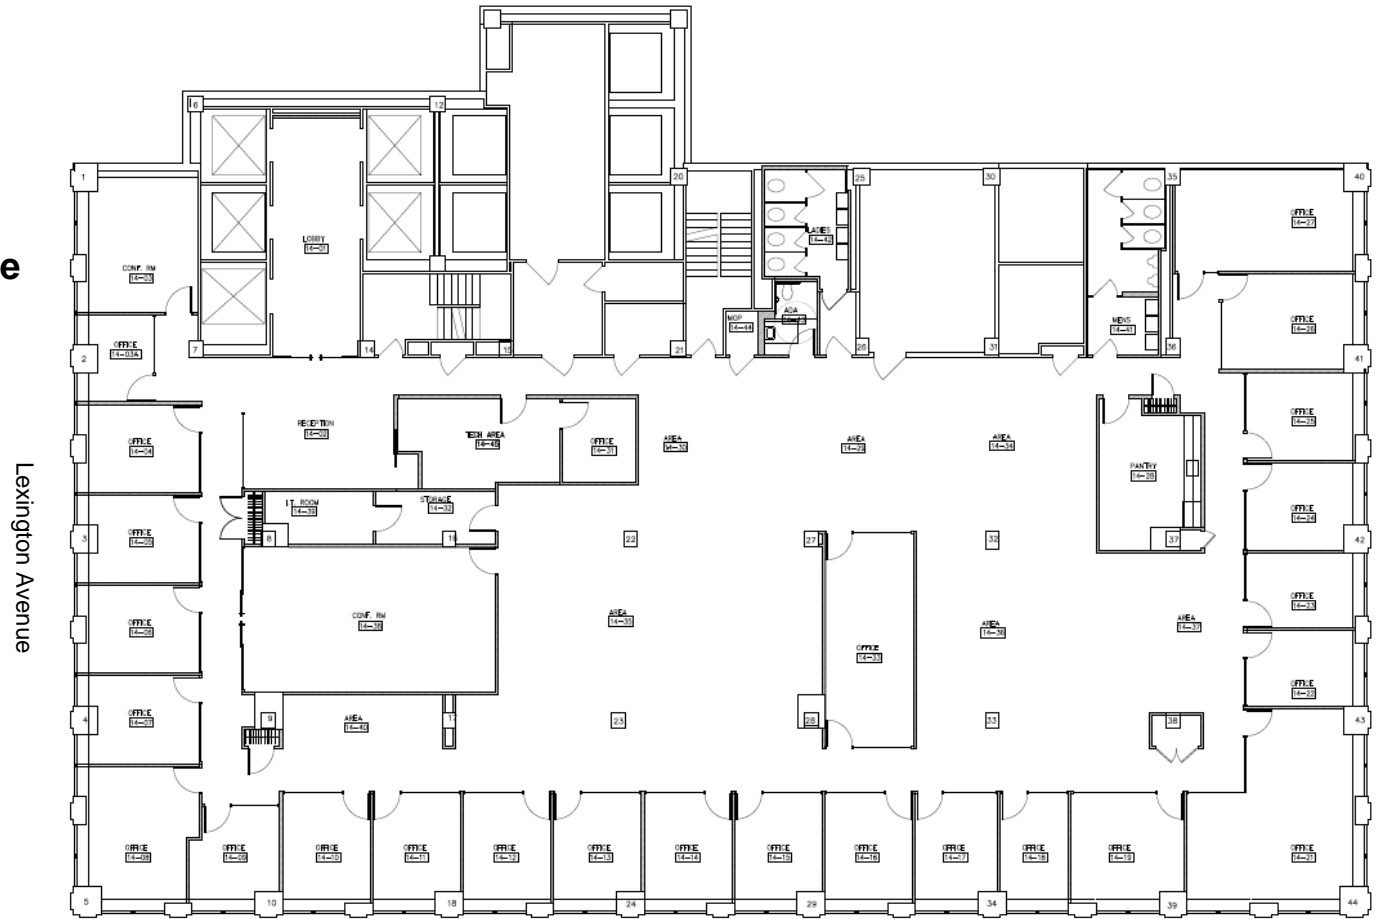

Thomas M. Keating

212.407.2481
tkeating@rudin.com

rudin.com



REBNY