


560 Lexington Avenue

Rudin

Floor 7
As Built Floor Plan

17,204 Sq. Ft.
Entire Floor Available

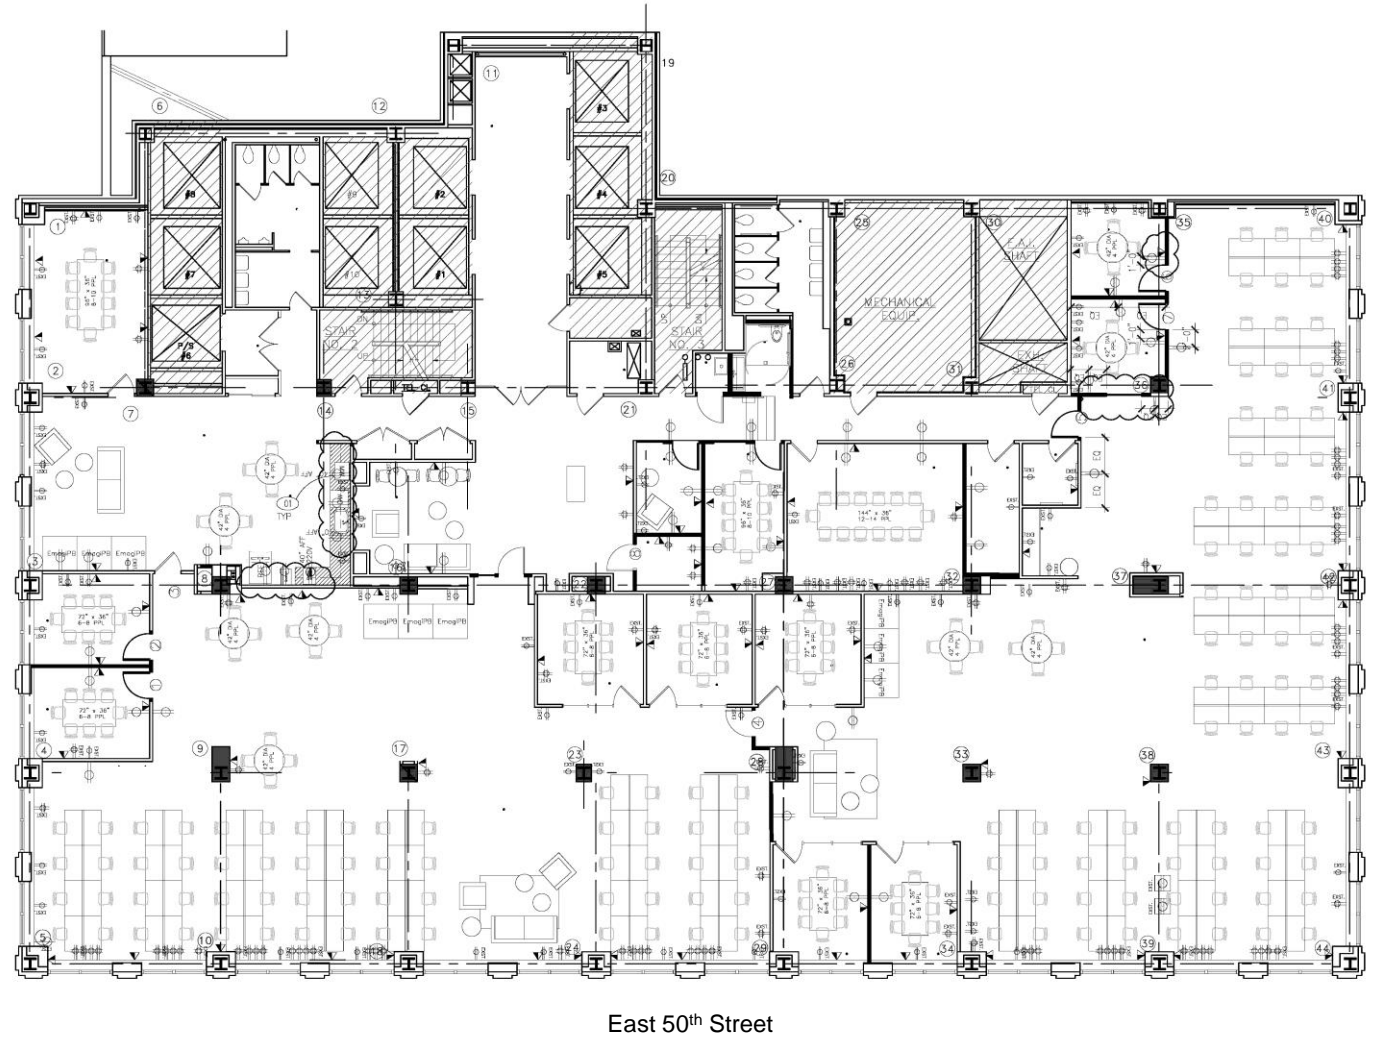

Robert Steinman

212.407.2490
rsteinman@rudin.com

rudin.com