


# 560 Lexington Avenue

Rudin

**Floor 18  
As Built Floor Plan**

**17,778 Sq. Ft.  
Entire Floor Available**

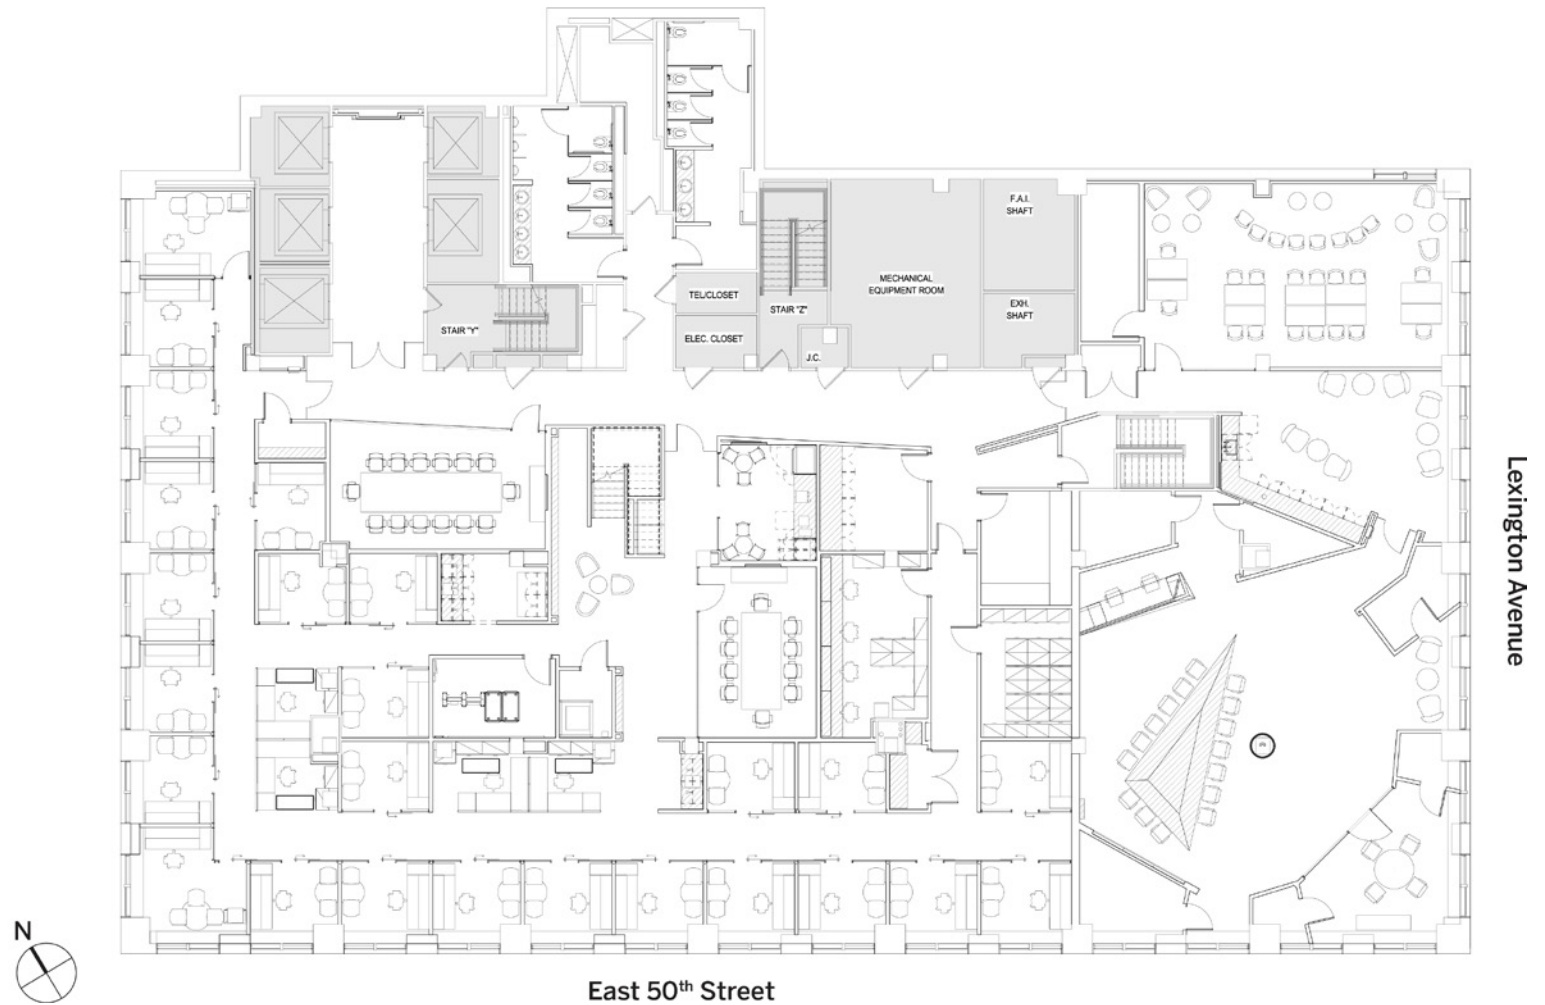

**Thomas M. Keating**

**Kevin Daly**

**Robert Steinman**

212.407.2481  
tkeating@rudin.com

212.407.2437  
kdaly@rudin.com

212.407.2490  
rsteinman@rudin.com

rudin.com



REBNY