


560 Lexington Avenue

Rudin

Floor 4
As Built Floor Plan

20,491 Sq. Ft.
Entire Floor Available

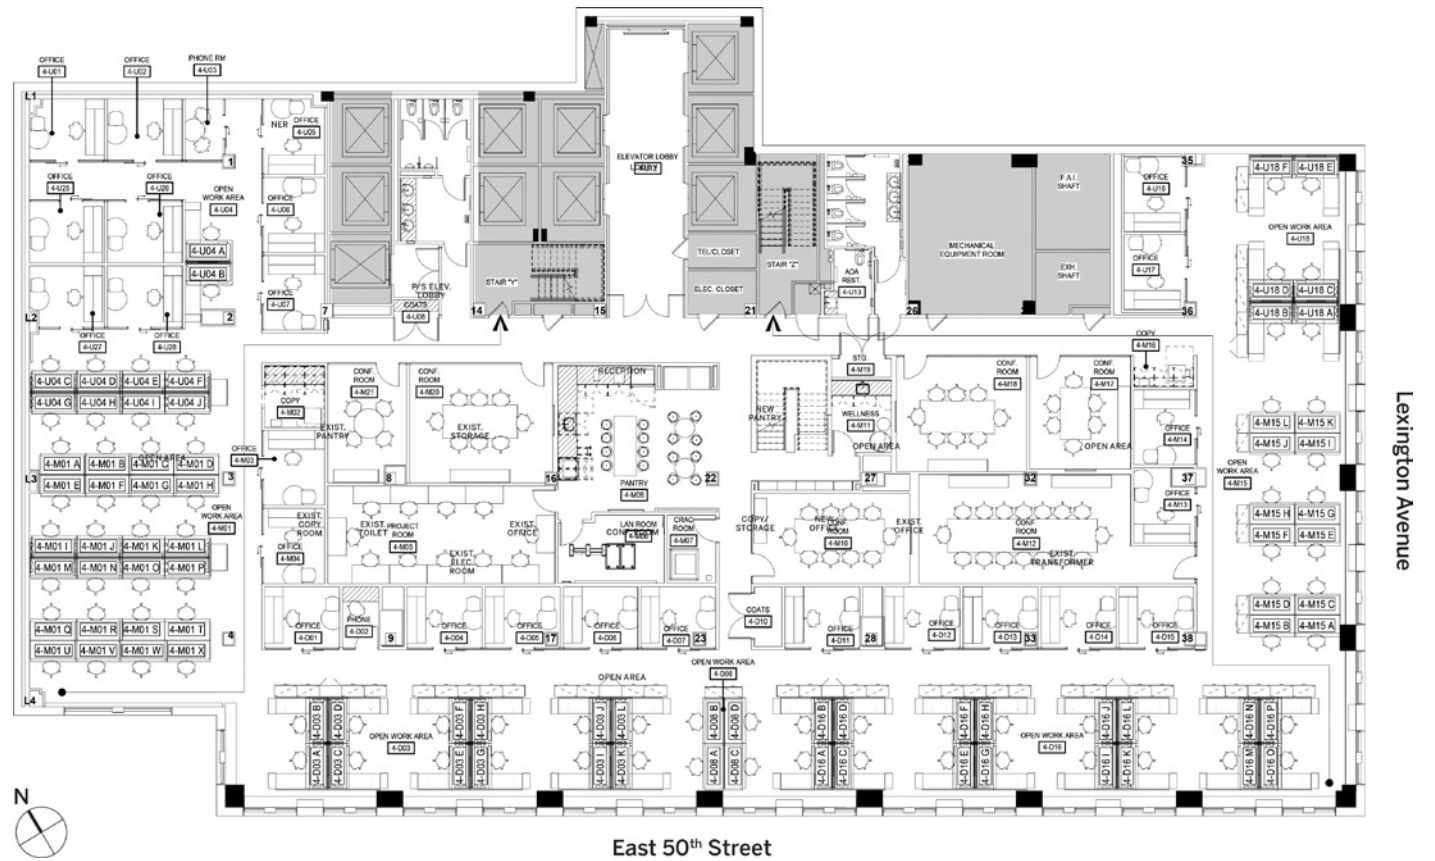

Thomas M. Keating

Kevin Daly

Robert Steinman

212.407.2481
tkeating@rudin.com

212.407.2437
kdaly@rudin.com

212.407.2490
rsteinman@rudin.com

rudin.com



REBNY