


# 641 Lexington Avenue

Rudin

Floor 10  
As Built Plan

16,665 Sq. Ft.  
Entire Floor Available

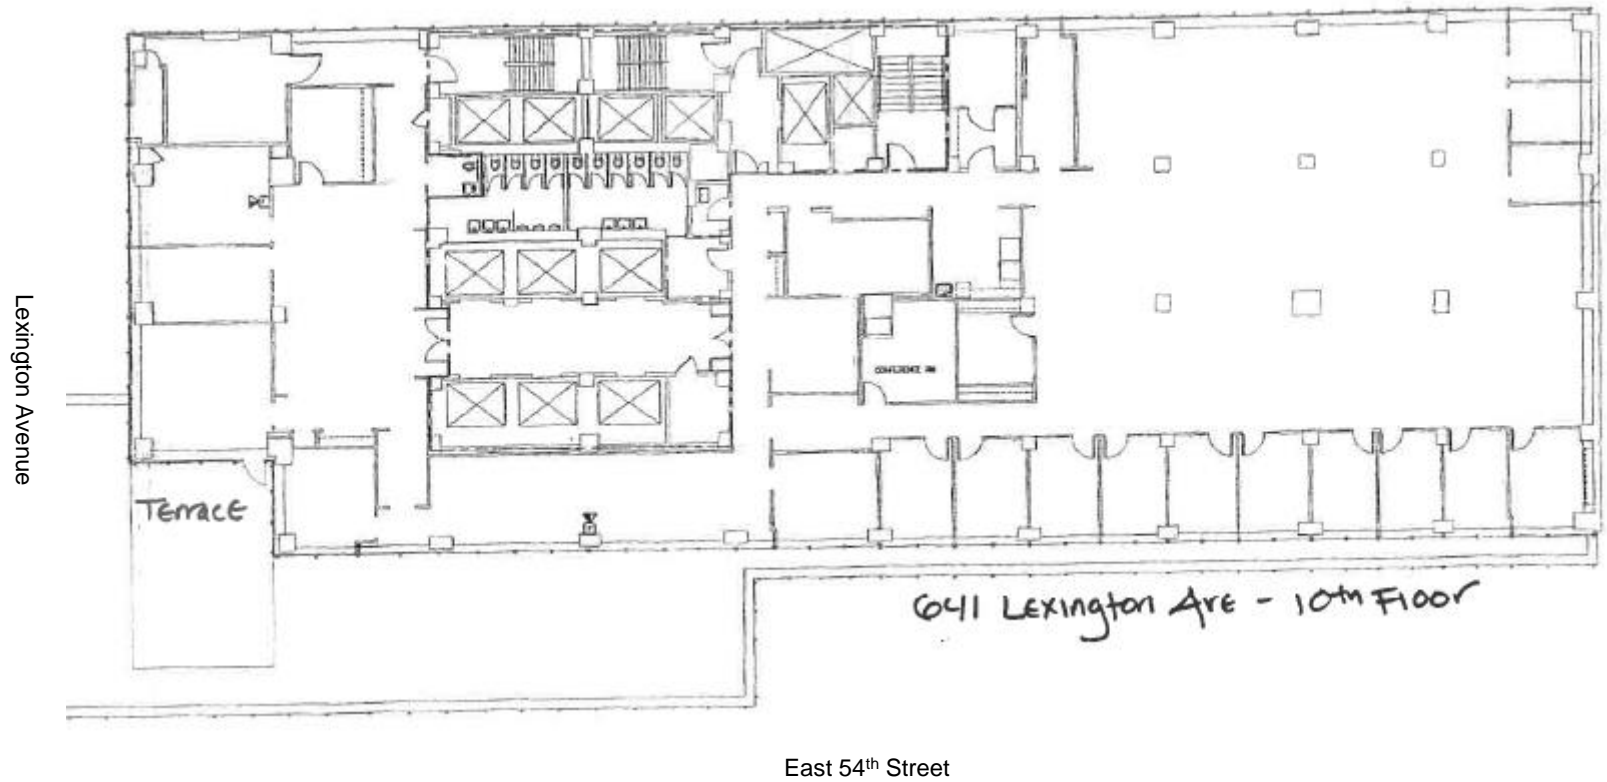

Robert Steinman

212.407.2490  
rsteinman@rudin.com

[rudin.com](http://rudin.com)