


641 LEXINGTON AVENUE

RUDIN

Floor 10
As Built Plan

16,665 Sq. Ft.
Entire Floor Available
Asking \$69 per RSF

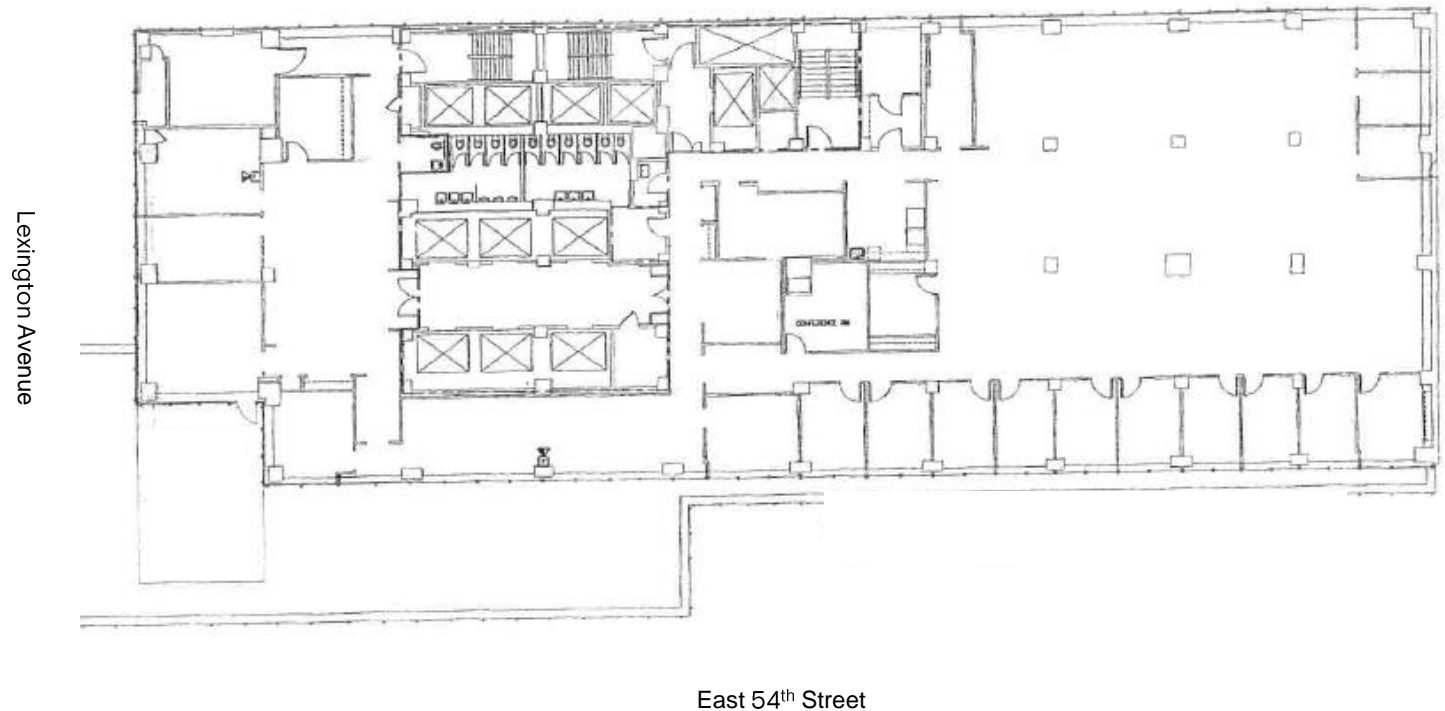

Robert Steinman

212.407.2490
rsteinman@rudin.com

rudin.com



REBNY