


641 Lexington Avenue

Rudin

Floor 31
As Built Plan

6,690 Sq. Ft.
Entire Floor Available

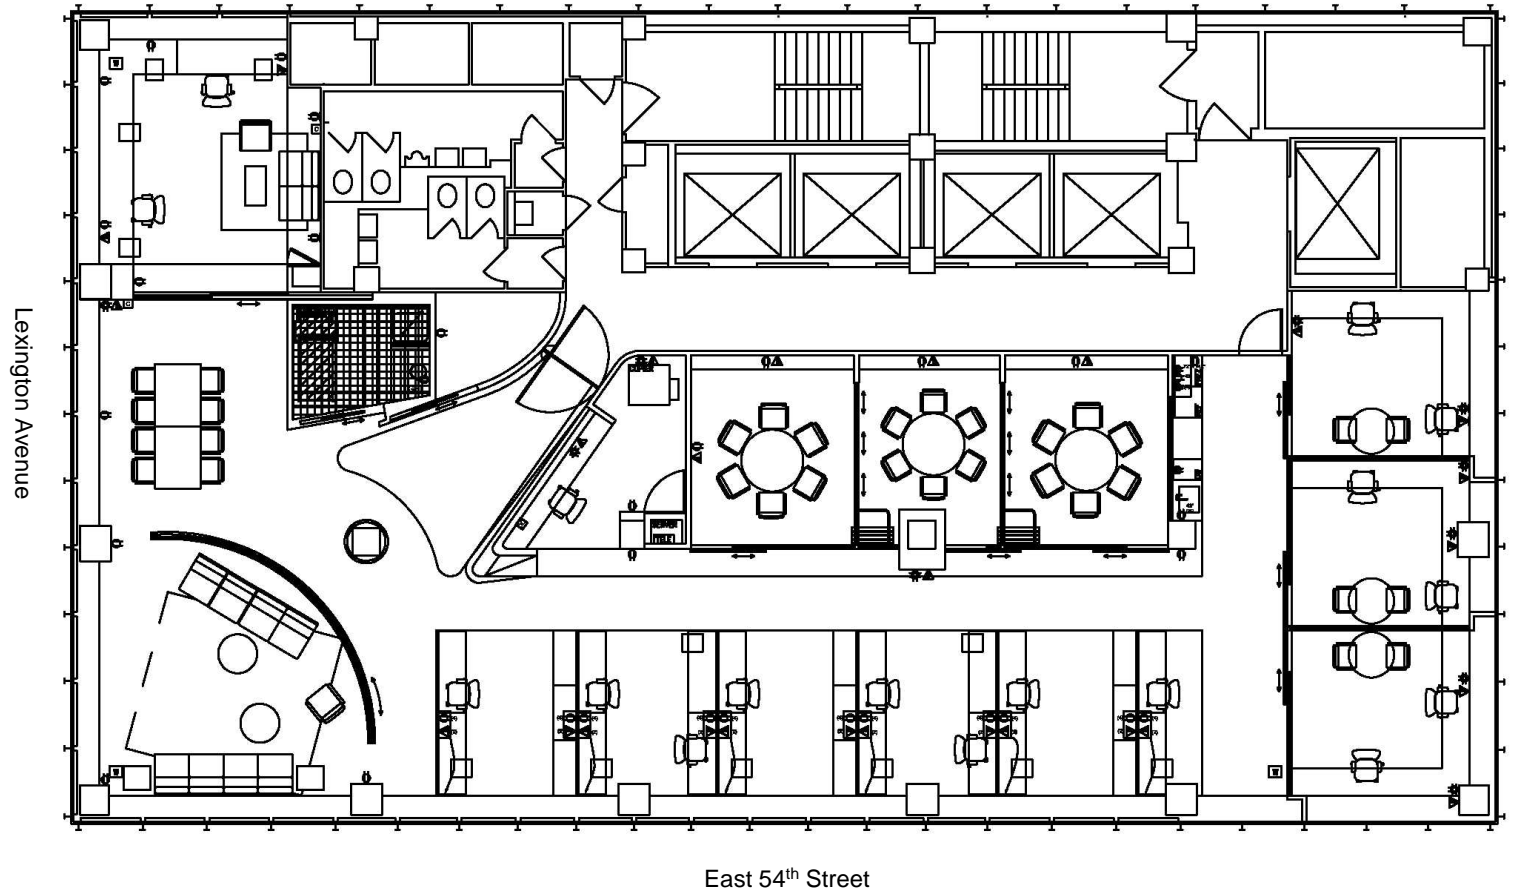

Robert Steinman

212.407.2490
rsteinman@rudin.com

rudin.com