
Rudín

641 Lexington Avenue

Floor 7 As Built Plan

30,485 Sq. Ft. Entire Floor Available May 1, 2023

Asking: \$65 per RSF

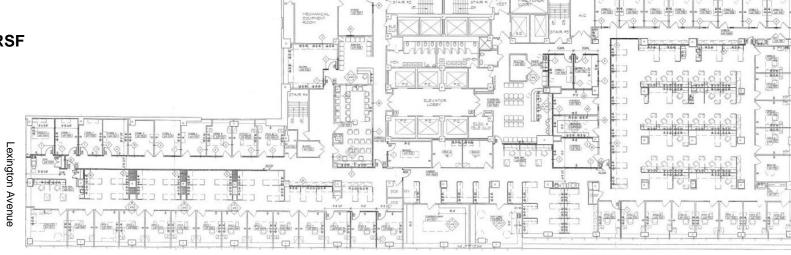

East 54th Street

Robert Steinman

212.407.2490 rsteinman@rudin.com

