


641 Lexington Avenue

Rudin

Floor 27
As Built Plan

4,205 Sq. Ft.
Partial Floor Available

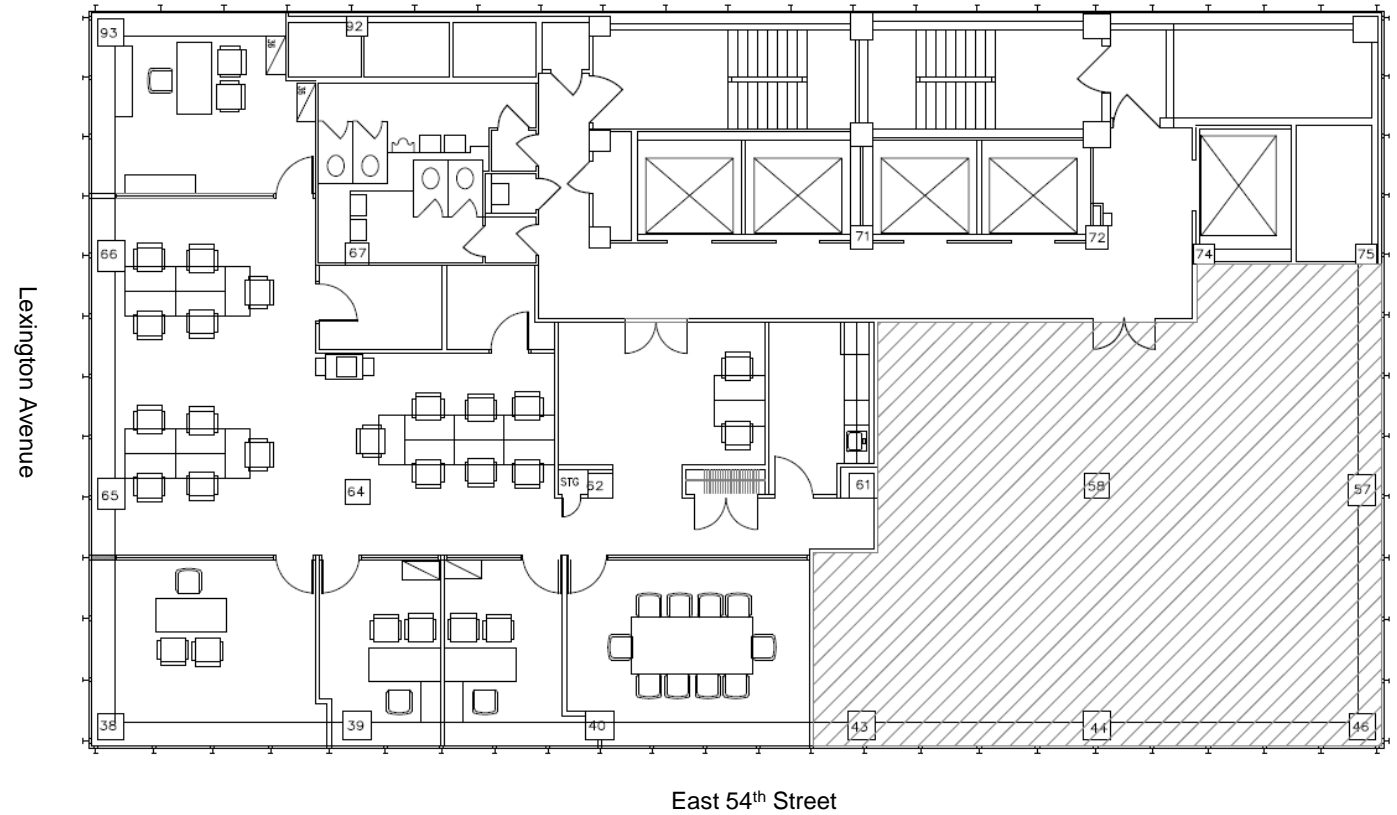

Robert Steinman

212.407.2490
rsteinman@rudin.com

rudin.com