


641 LEXINGTON AVENUE

RUDIN

Floor 22
As Built Plan
3,110 Sq. Ft.
Partial Floor Available
Asking \$69 per RSF

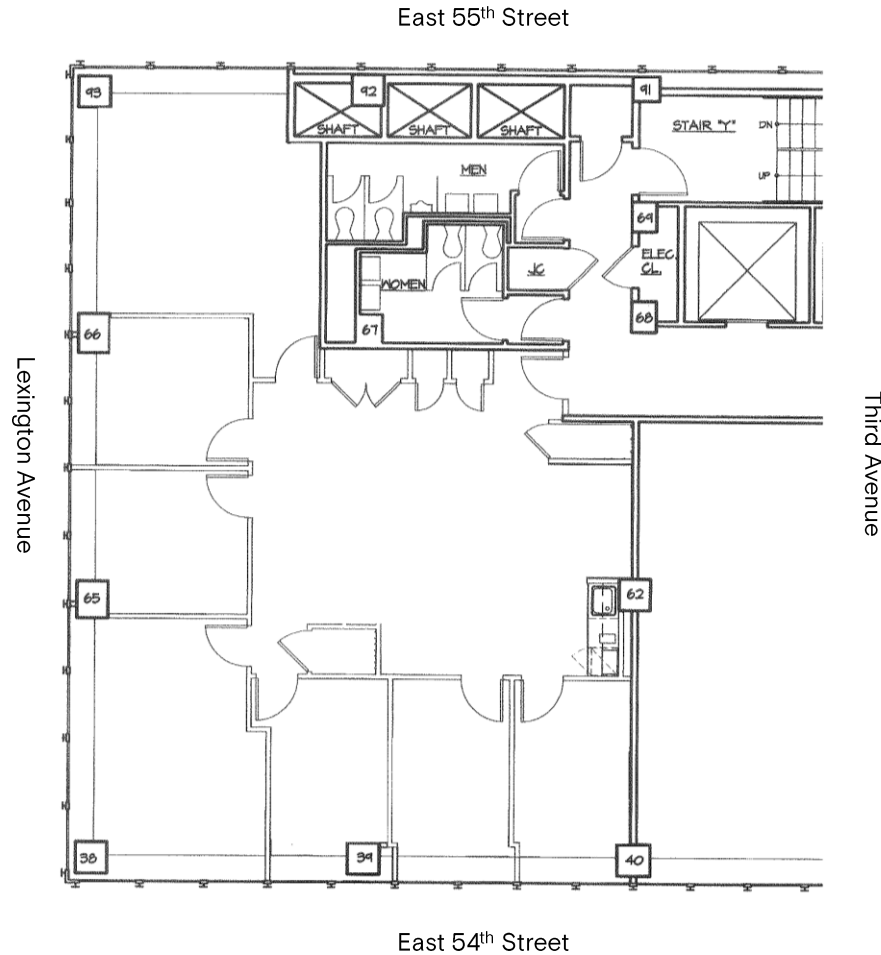

Robert Steinman

212.407.2490
rsteinman@rudin.com

rudin.com



REBNY