


641 LEXINGTON AVENUE

RUDIN

Floor 27
As Built Plan
2,514 Sq. Ft.
Partial Floor Available
September 1, 2025

Asking \$69 per RSF

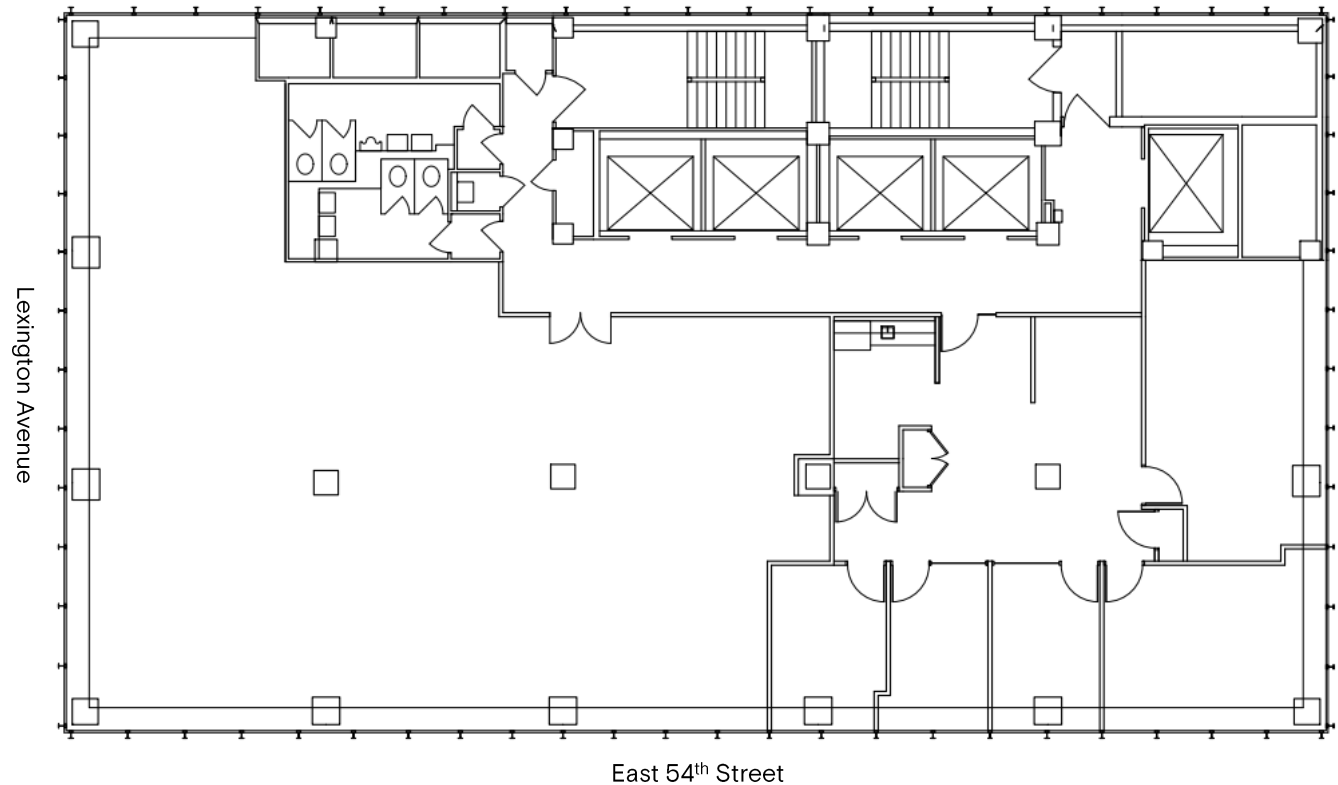

Robert Steinman

212.407.2490
rsteinman@rudin.com

rudin.com



REBNY