


# 80 Pine

Partial Ground As-Built Plan  
Located on Maiden Lane

Ground – 1,067 Sq. Ft.  
Basement – 300 Sq. Ft.

Available September 2023

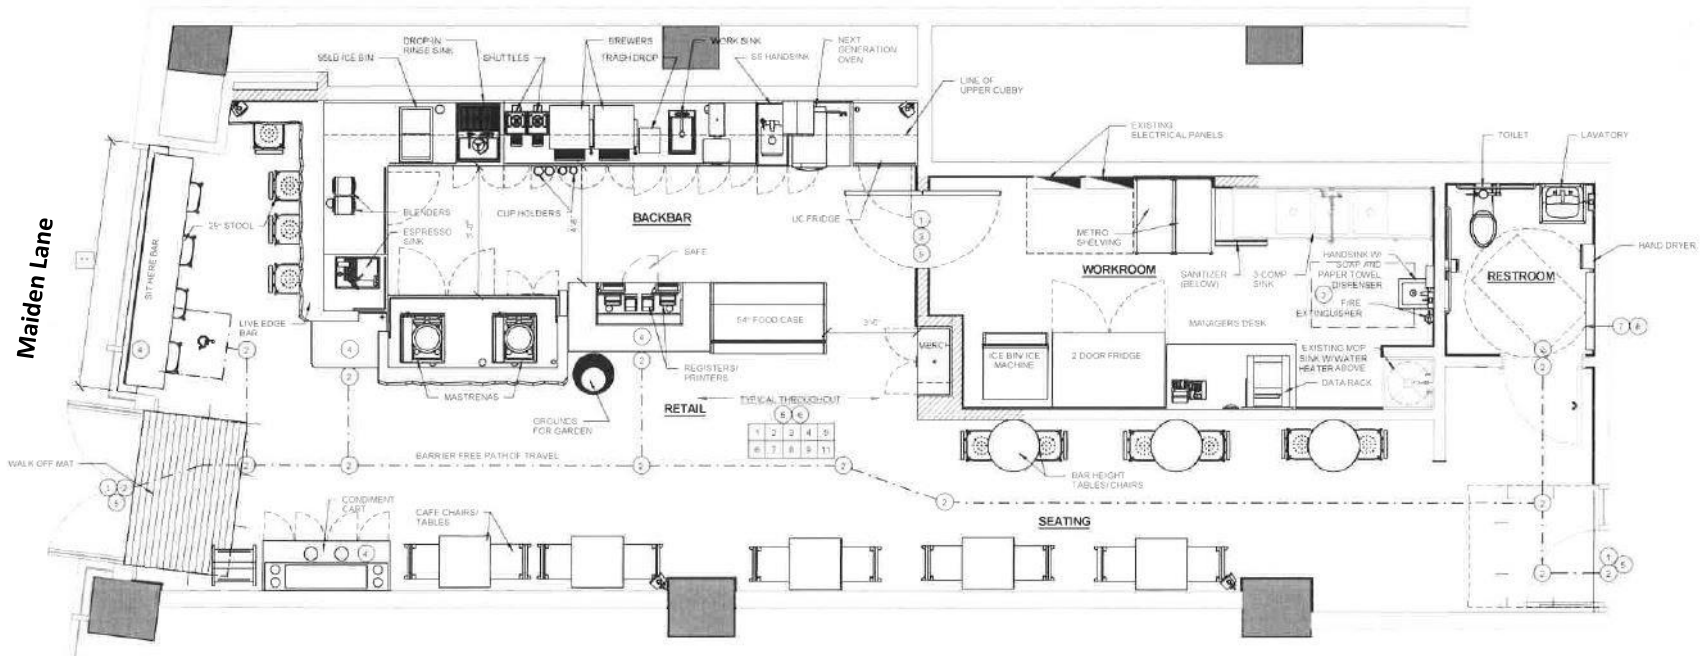

Kevin Daly      Thomas M. Keating  
212.407.2437      212.407.2481  
kdaly@rudin.com      tkeating@rudin.com