


845 Third Avenue

Rudin

Floor 21
As Built Plan

5,772 Sq. Ft.
Entire Floor Available

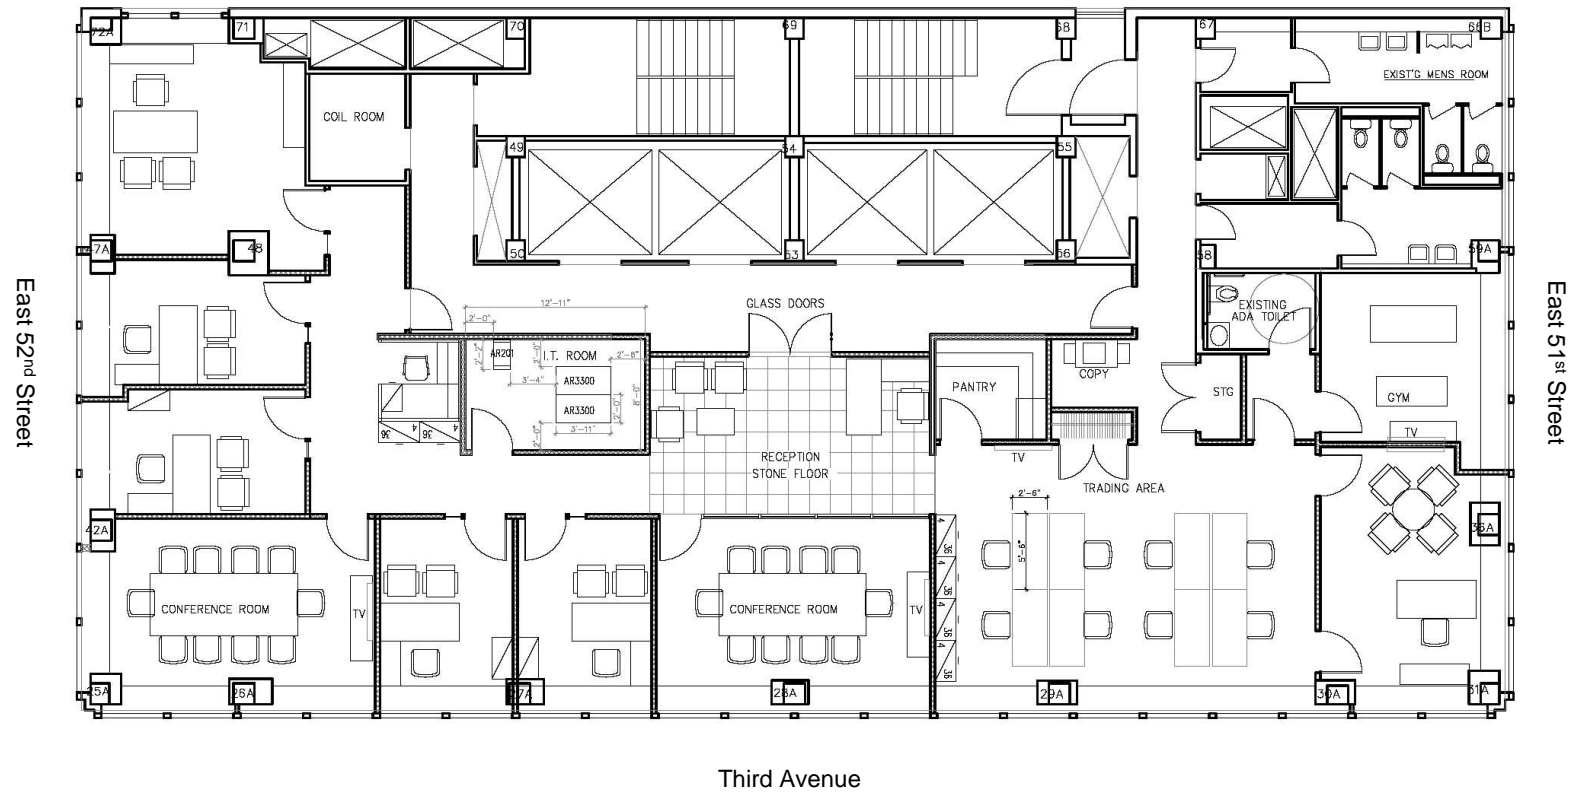

Robert Steinman

212.407.2490
rsteinman@rudin.com

rudin.com