
845 Third Avenue

Floor 13 As Built Plan

15,862 Sq. Ft. Entire Floor Available June 2023

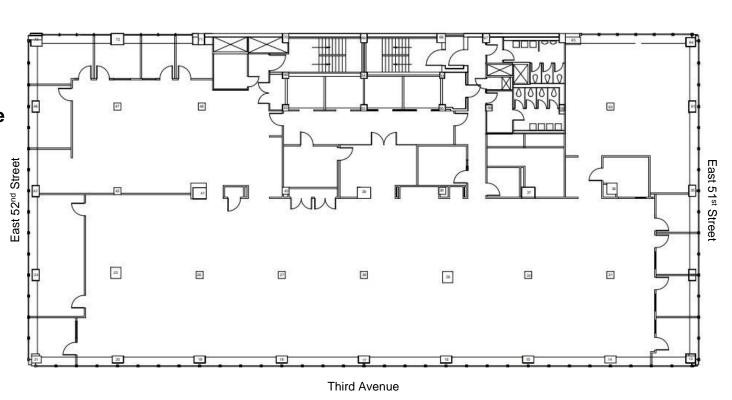

Robert Steinman

212.407.2490 rsteinman@rudin.com

