


845 Third Avenue

Rudin

Floor 15
As Built Plan

15,862 Sq. Ft.
Entire Floor Available
June 2023

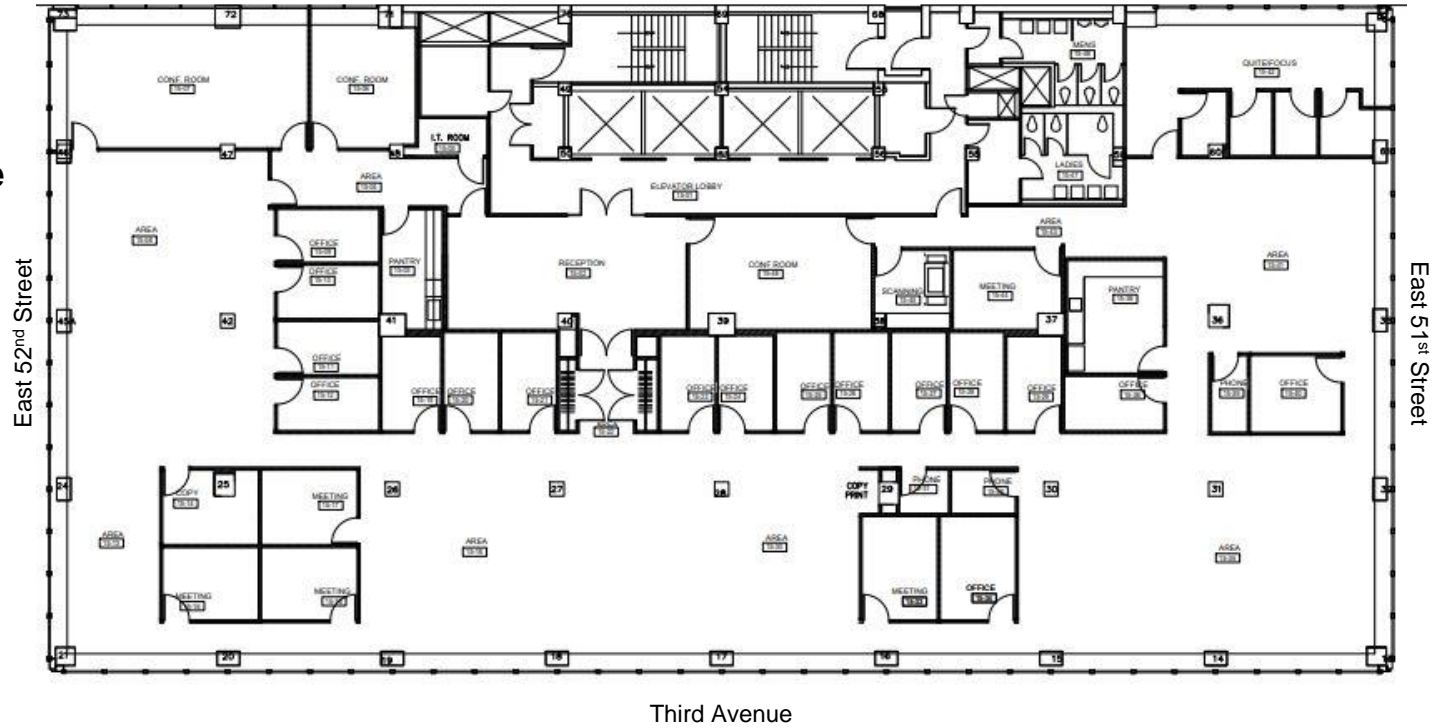

Robert Steinman

212.407.2490
rsteinman@rudin.com

rudin.com



REBNY