


# 845 Third Avenue

Rudin

Floor 18  
As Built Plan

5,772 Sq. Ft.  
Entire Floor Available  
June 2023

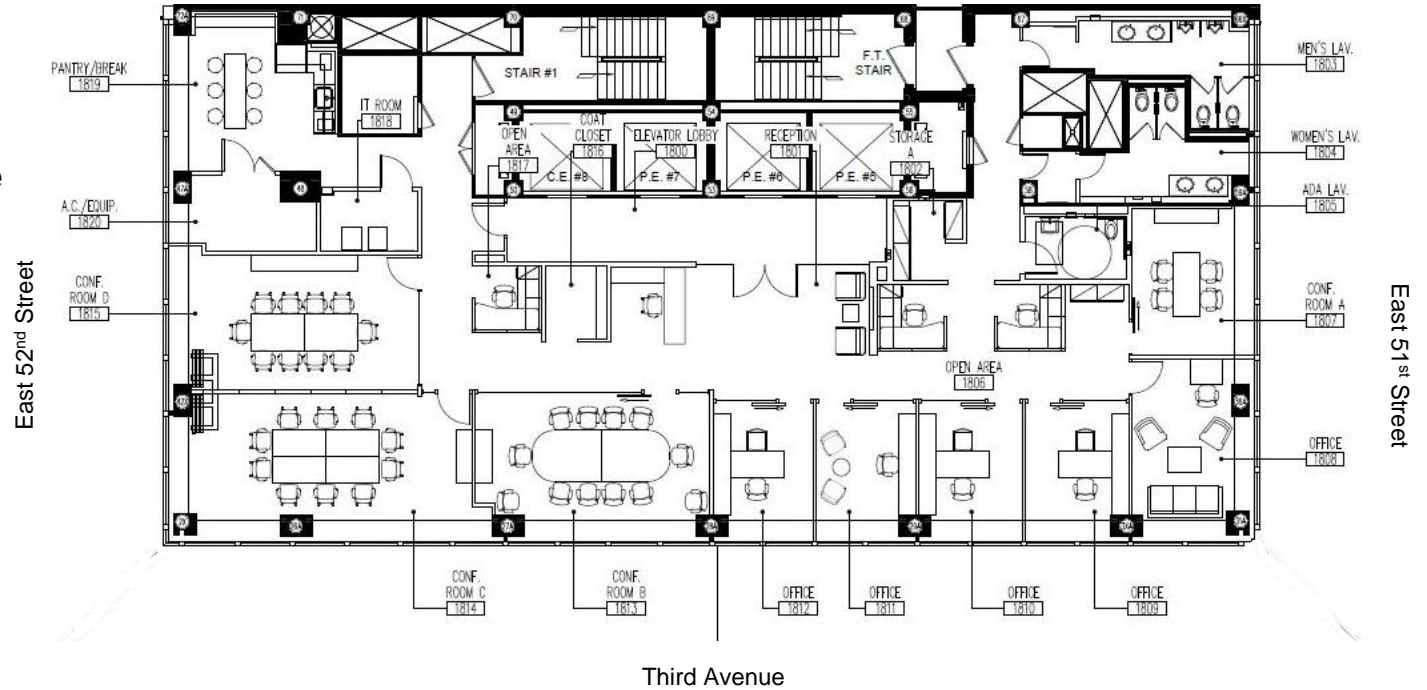

Robert Steinman

212.407.2490  
rsteinman@rudin.com

rudin.com



REBNY