


# 845 Third Avenue

Rudin

Floor 4  
As Built Plan

24,215 Sq. Ft.  
Entire Floor Available  
June 2023

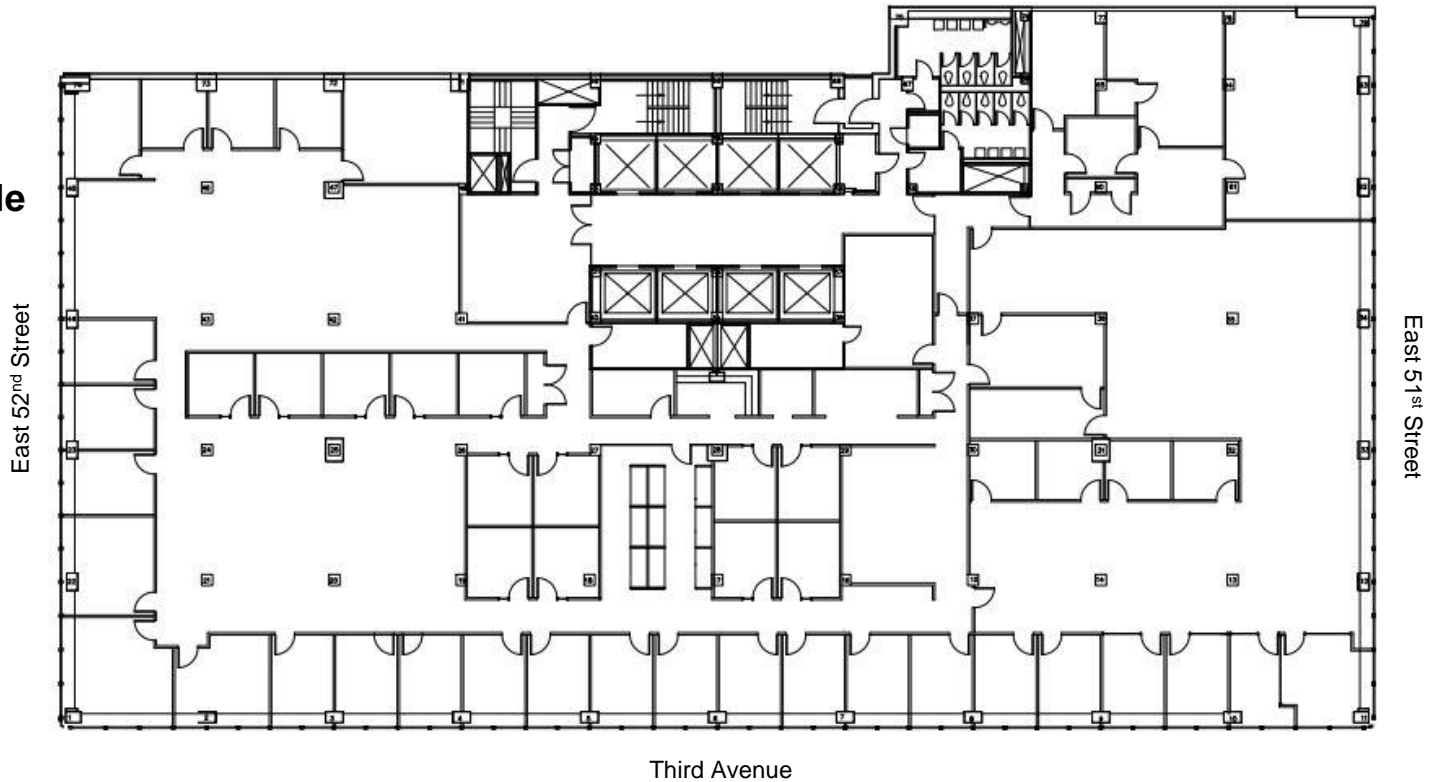

Robert Steinman

212.407.2490  
rsteinman@rudin.com

[rudin.com](http://rudin.com)



REBNY