


845 Third Avenue

Rudin

Floor 16
As Built Plan

5,805 Sq. Ft.
Partial Floor Available

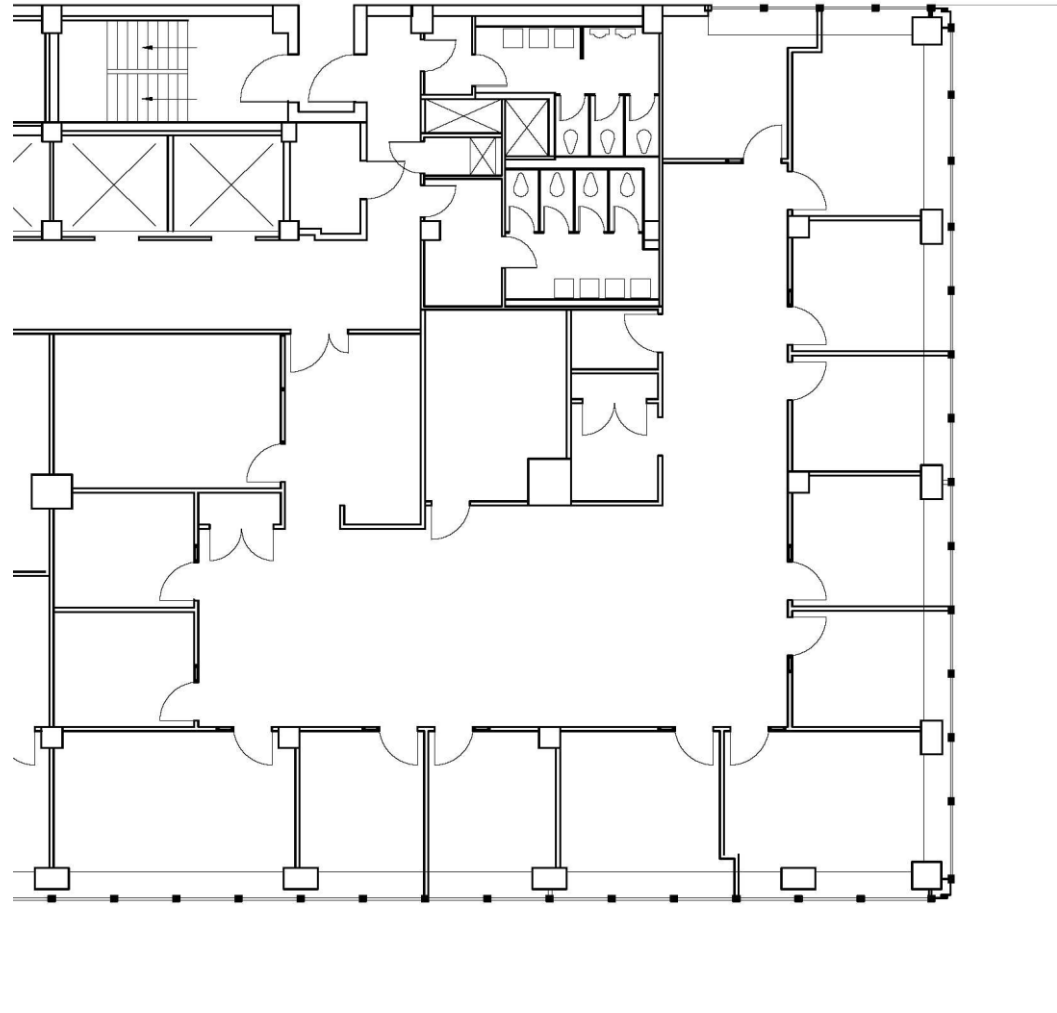

East 51st Street

Third Avenue

Robert Steinman

212.407.2490
rsteinman@rudin.com

rudin.com