


845 Third Avenue

Rudin

Floor 17
As Built Floor Plan

4,611 Sq. Ft.
Partial Floor Available

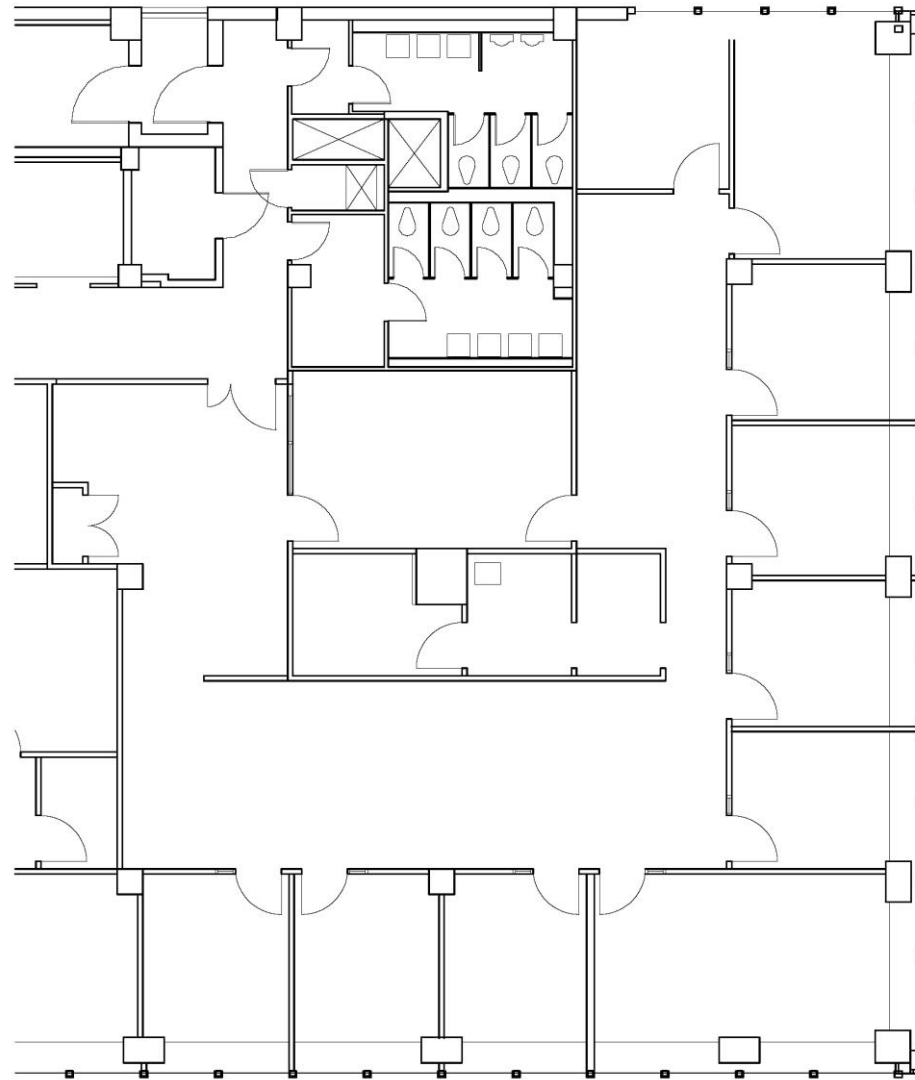

East 51st Street

Third Avenue

Robert Steinman

212.407.2490
rsteinman@rudin.com

rudin.com



REBNY